


T.20 S., R.7 W., W.M.

SEC. 29

SW 1/4 SE 1/4

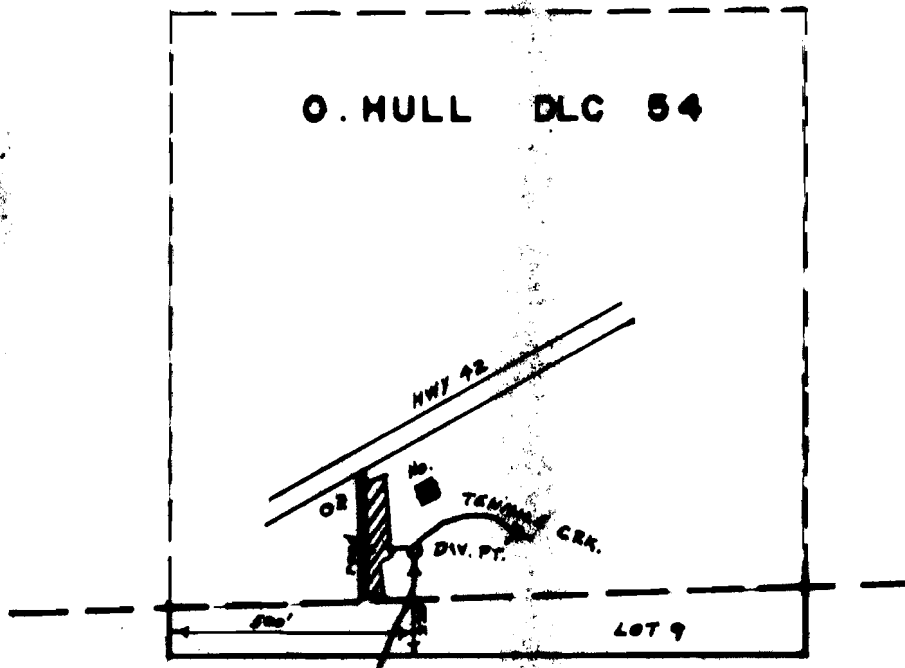

SCALE 1" = 400'

FINAL PROOF SURVEY
UNDER

Application No. 55787 Permit No. 41771
IN NAME OF

FRED W. NICHOLS

Surveyed JUNE.... 1973 by JS DONALDSON