


T.26S.,R.7W.,W.M.
Section 34

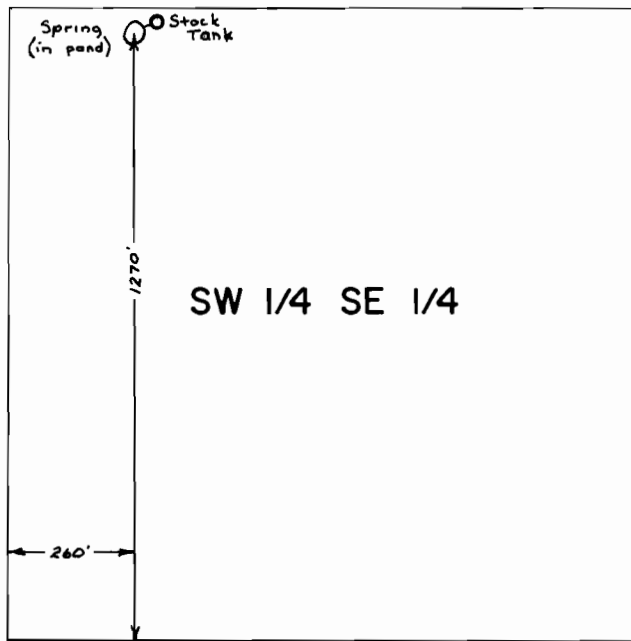

■ No.

SCALE: 1" = 400'

FINAL PROOF SURVEY
UNDER

Application No. .55780. Permit No. ...42225....
IN NAME OF

FRITZ L. & MILDRED R. SJOGREN

Surveyed March 31, 1980, by J.S. DONALDSON