


T.28S., R.7 W., W.M.

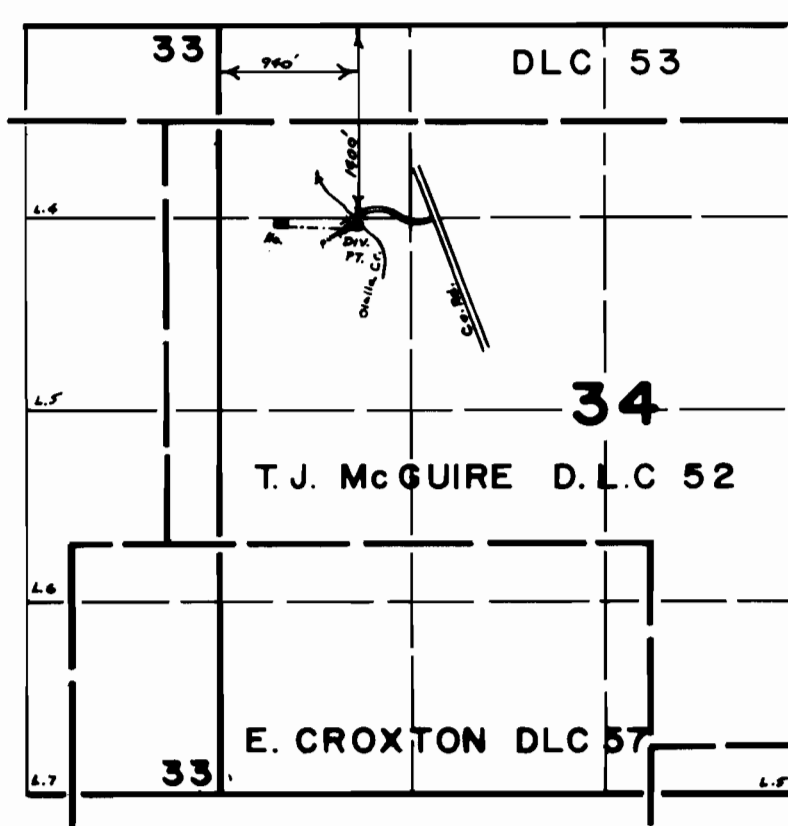

SCALE 4" = 1 mile

**FINAL PROOF SURVEY**  
UNDER

Application No. 58221... Permit No. 43811...  
IN NAME OF

ISAAC JAMES

Surveyed June 6, 1979, by S. Donaldson.