


P 54767
C-54169

T.1S. R.21E. W.M.

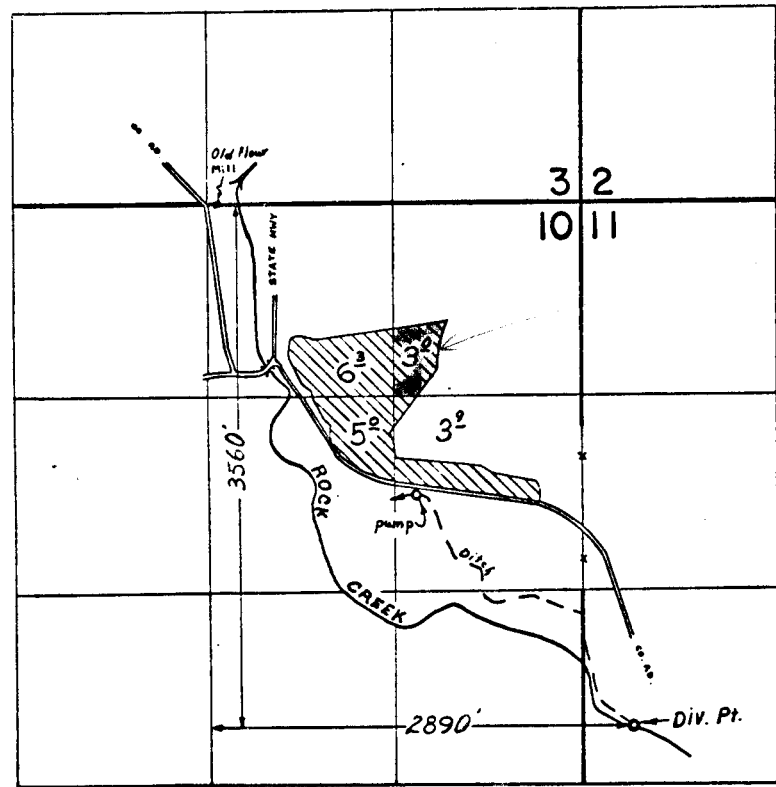

Application No. 53192
 Permit No. 39469

FINAL PROOF SURVEY UNDER

RECEIVED
 JUN 2 1975
 STATE ENGINEER
 SALEM, OREGON

Application No. 48313 Permit No. 36278
 IN NAME OF
ESTATE OF BENTLEY C. RIES
 Surveyed APRIL 10, 1974, by L.E. GOULD