


P. 41208  
C- 54170

# T. 1S, R. 21E, W. M.

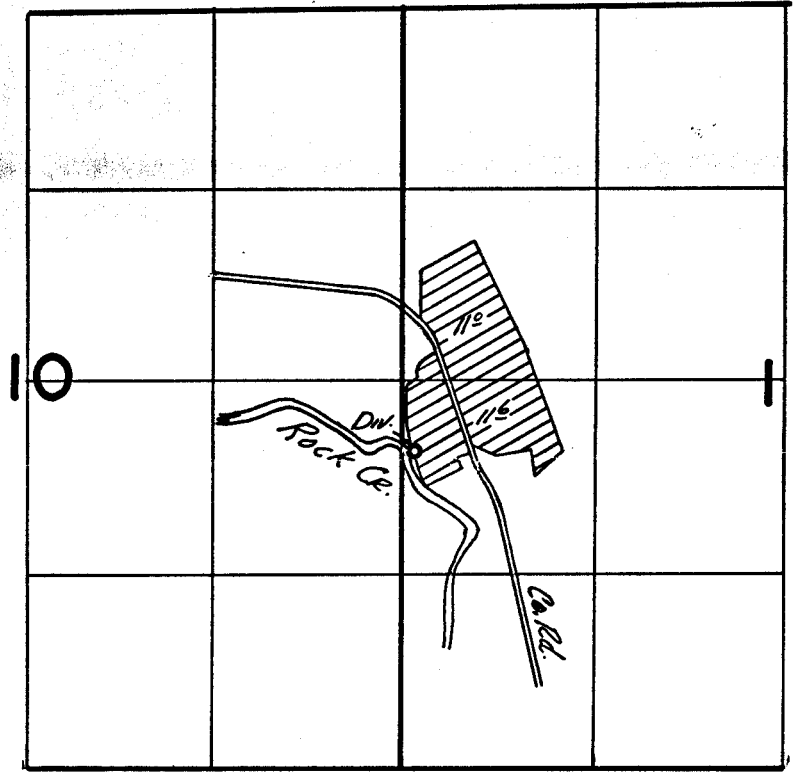

*D.W. Pl. Located: 3040'S & 50'E from NW Cor. Sec. 11*

## FINAL PROOF SURVEY UNDER

Application No. 54990. Permit No. 41208.....  
IN NAME OF

.....FRANK A. BETTENCOURT.....

Surveyed June 14, 1979, by S. C. BROWN.....