


T. 38 S., R. 1 W., W.M.

SEC. 35

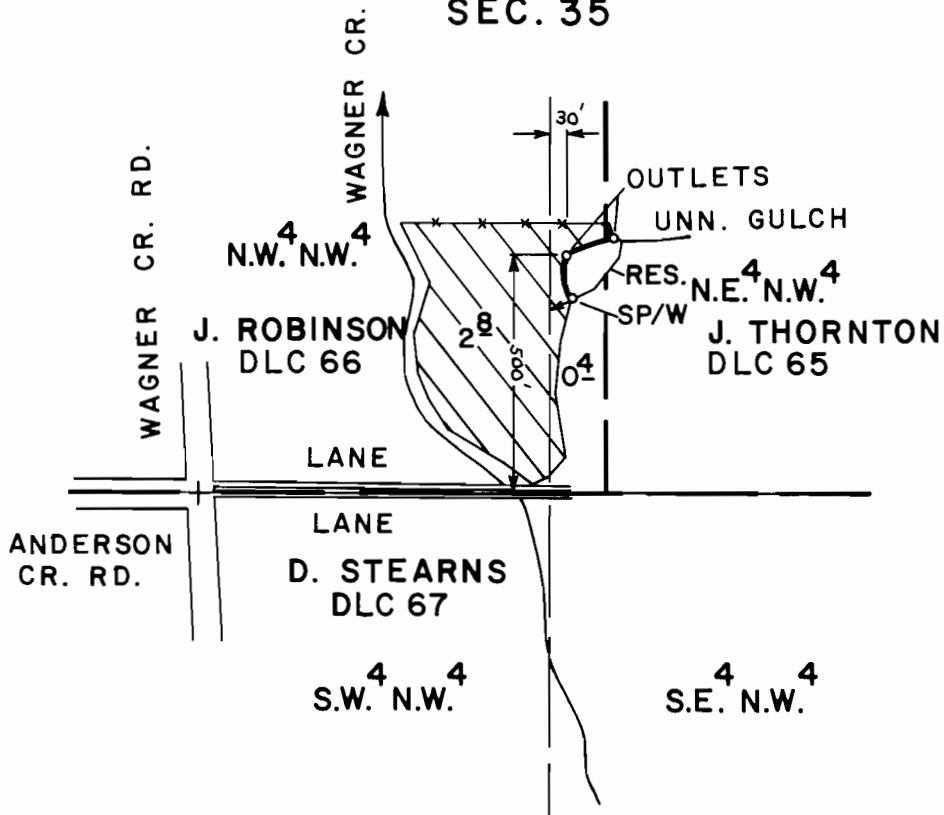

SCALE : 1" = 400 FT.

FINAL PROOF SURVEY UNDER

Application No. R-51254 51255 Permit No. R-6220 38802 SUPPL.
IN NAME OF

JACKSON FRYE

Surveyed JUN. 1 1979, by B. SUND

D.H.M.
P.T.S.-1979-14-B
& BAX-1AA-74