


# T. 38 S., R. 1 W., W. M.

SEC. 34

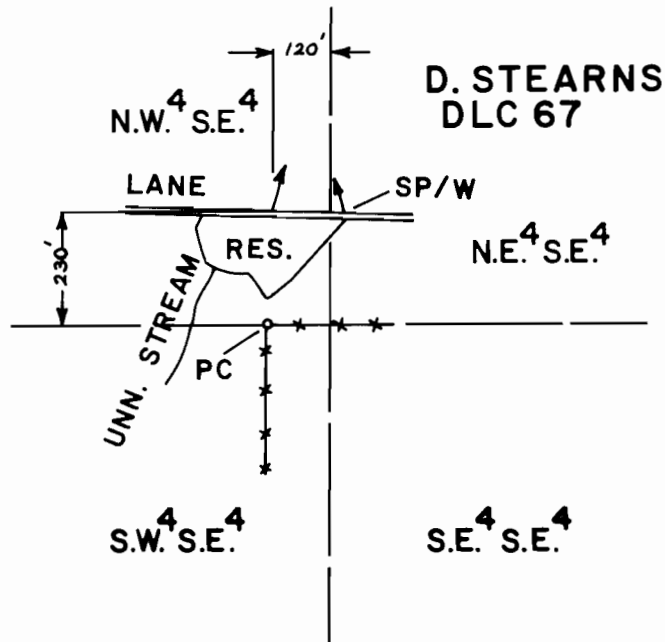

SCALE : 1" = 400 FT.

## FINAL PROOF SURVEY UNDER

Application No. R-58083 57931 Permit No. R-7774 43782  
IN NAME OF

C. D. FORT MILLER

Surveyed MAY 2 1979, by B. SUND

D.H.M.  
P.T.S. - 1979 - 14 - A