


T. 38 S., R. 1 W., W. M.

SEC. 34

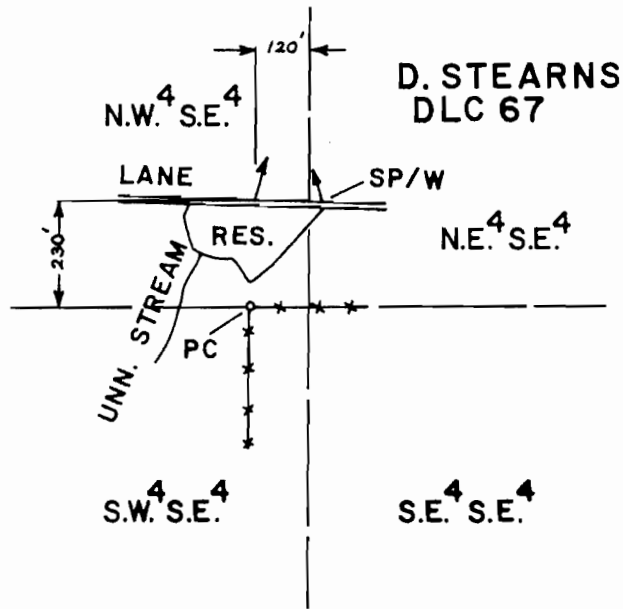

SCALE: 1" = 400 FT.

FINAL PROOF SURVEY
UNDER

R-58083 R-7774
Application No. 57931 Permit No. 43782
IN NAME OF

C. D. FORTMILLER

Surveyed MAY 2 1979 by B. SUND

D.H.M.
P.T.S.-1979-14-A