


T. 36 S., R. 3 W., W.M.

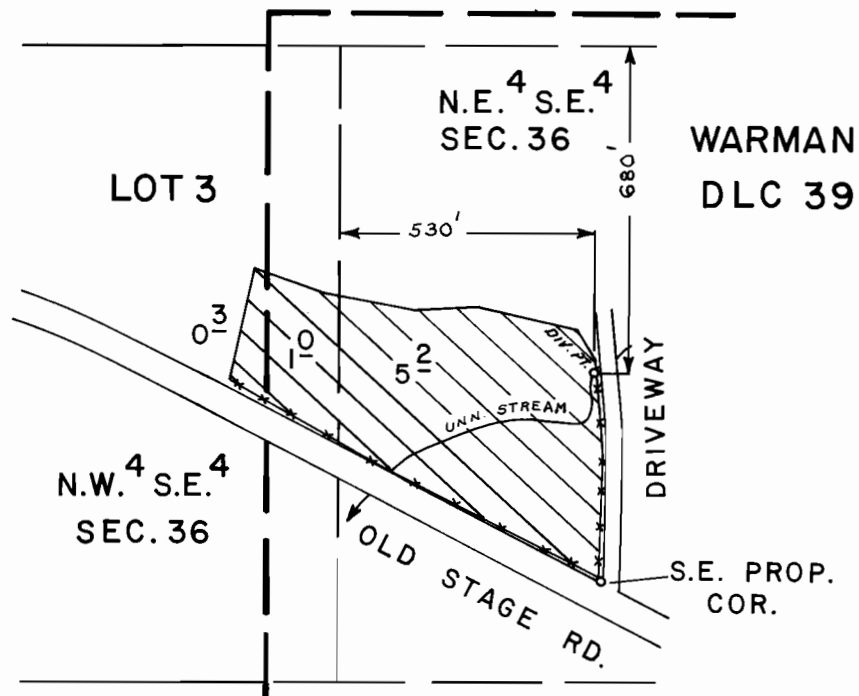

SCALE : 1" = 400 FT.

FINAL PROOF SURVEY
UNDER

Application No. 53161 Permit No. 38628
IN NAME OF

DAN B. PAULSEN &/OR JAMES A. KARLES

Surveyed MAY 23 1979, by B. SUND

D.H.M.
P.T.S. - 1979 - 14 - B