


# T. 38 S., R. 4 W., W.M.

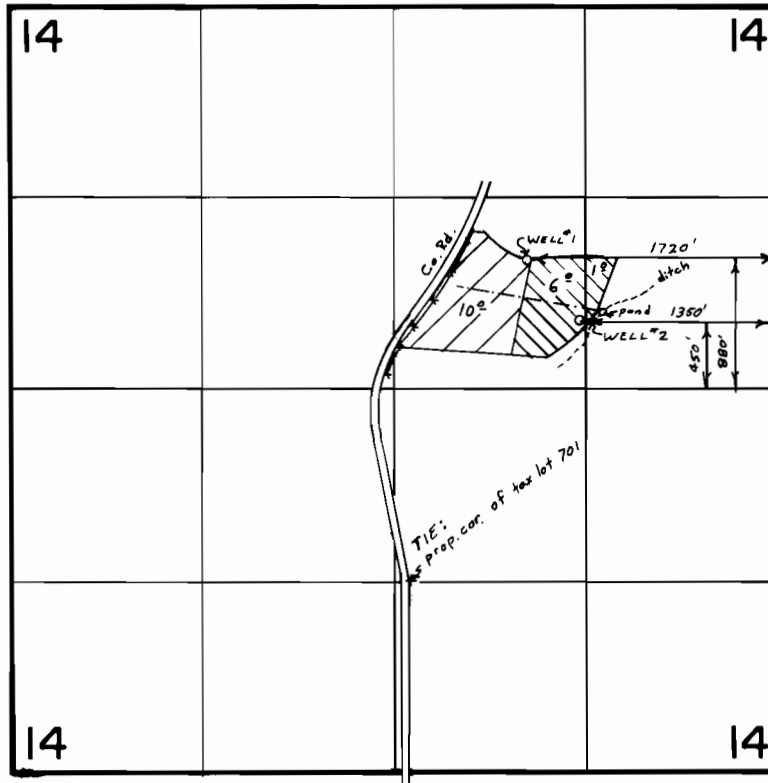

Primary

Supp'l

## FINAL PROOF SURVEY UNDER

Application No. G-6857. Permit No. G-6396..  
IN NAME OF

.....THOMAS.....R.....PITTOCK.....Jr.....

Surveyed June..5.. 1979., by Bruce..R..Sund..