


T. 37 S., R. 2 W., W.M.

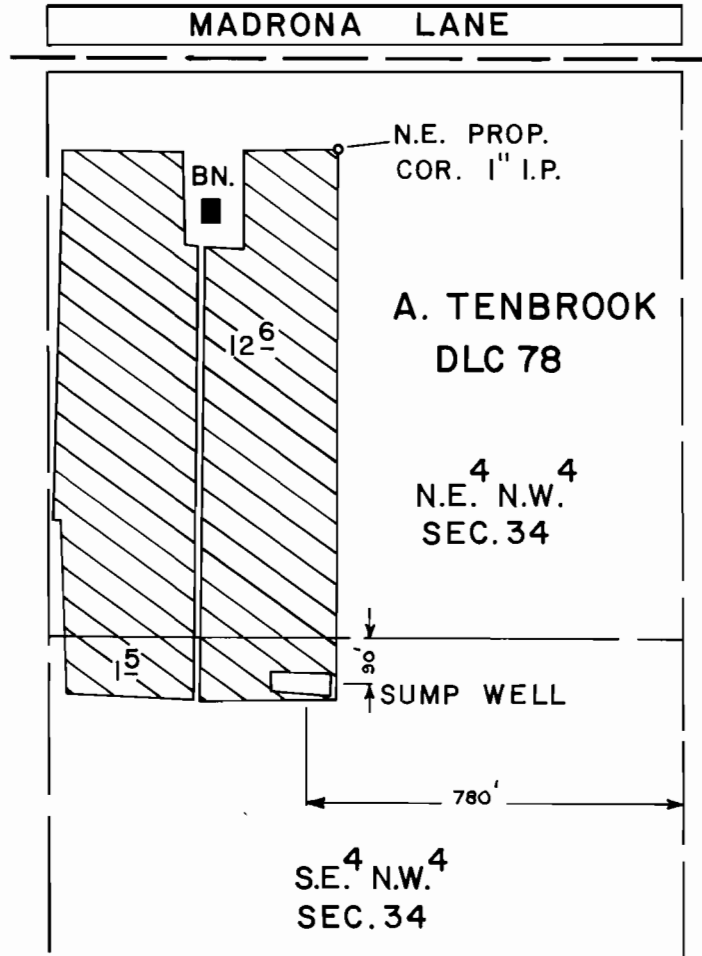

SCALE: 1" = 400 FT.

FINAL PROOF SURVEY UNDER

Application No. G-8632 Permit No. G-8002
IN NAME OF

DELAIRE F. TUSOW

Surveyed MAY 10 1979, by B. SUND

D.H.M.

P.T.S.-1979-14-A