


T. 40 S., R. 7 W., W.M.

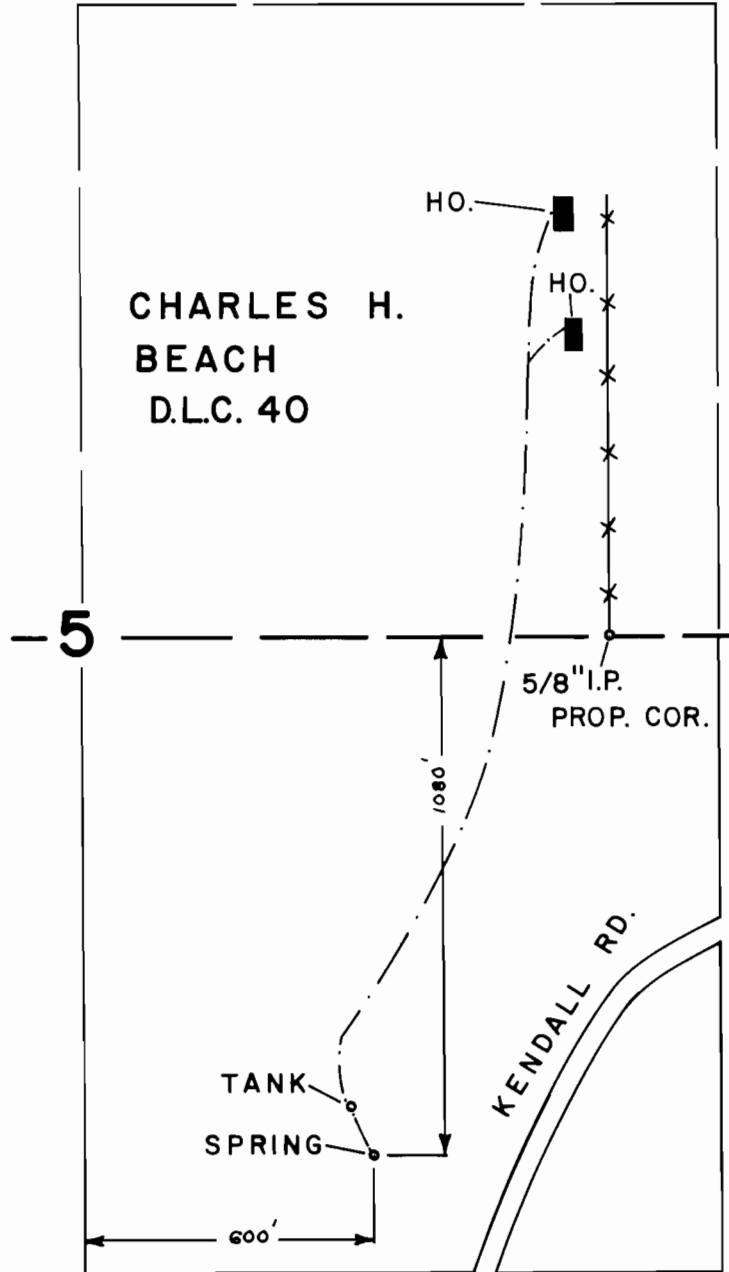

SCALE : 1" = 400 FT.

FINAL PROOF SURVEY
UNDER

Application No. 55186 Permit No. 41541
IN NAME OF

EDWARD LEE GERBER & MERIDETH R. MIDDOUGH

Surveyed JUN. 12 1979, by B. SUND

D.H.M.
P.T.S. - 1979 - 14 - B