


T. 40 S., R. 8 W., W.M.

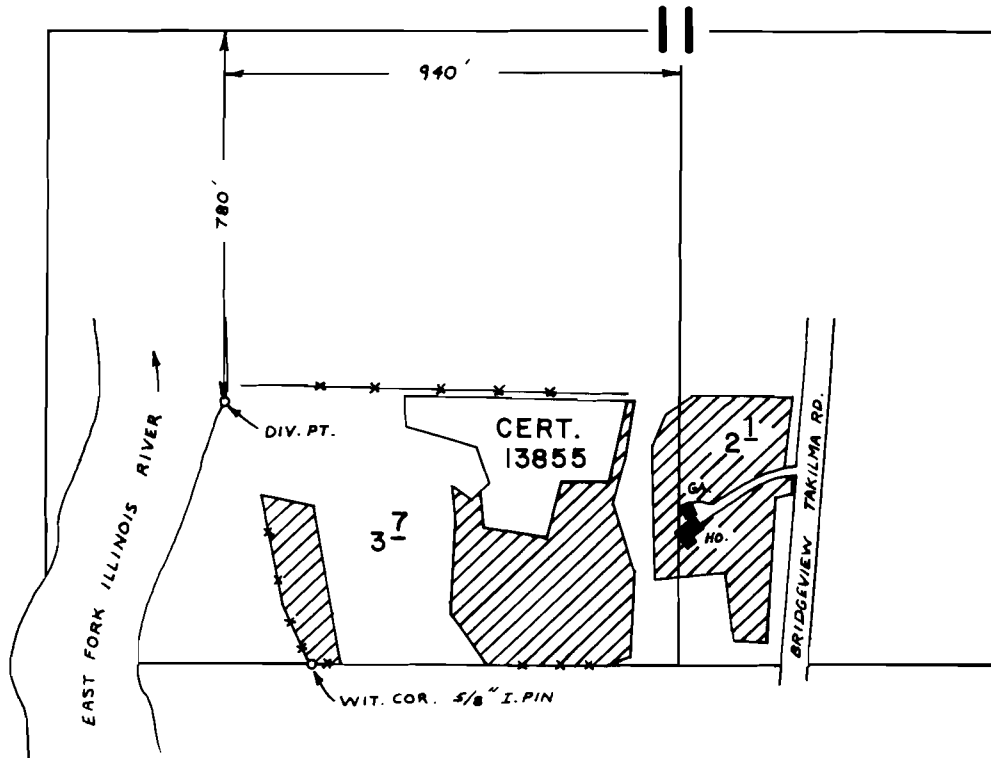

SCALE : 1" = 400 FT.

**FINAL PROOF SURVEY**  
UNDER

Transfer No. 3131

Application No. 52950 Permit No. 39975  
IN NAME OF

WILLIAM R. WATSON

Surveyed JUN. 13 1979, by B. SUND