


T. 36S. R. 21E. W.M.

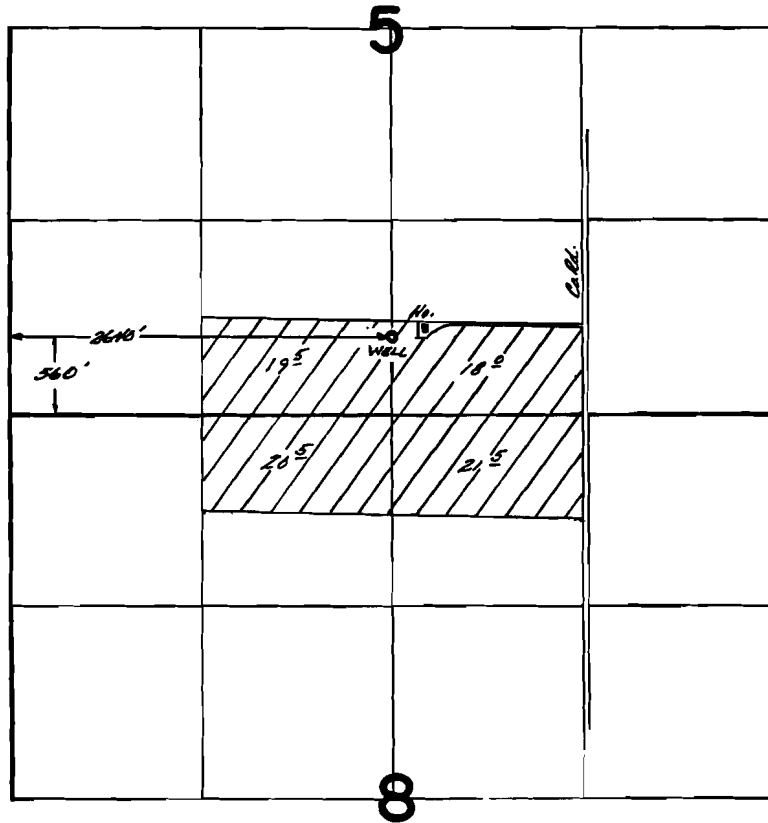

FINAL PROOF SURVEY UNDER

Application No. G-8098 Permit No. G-7483....
IN NAME OF

.....RICHARD WEEKLY.....

Surveyed Oct...17... 1979., by S.C.BROWN.....