


T.40S.,R.19E.,W.M.

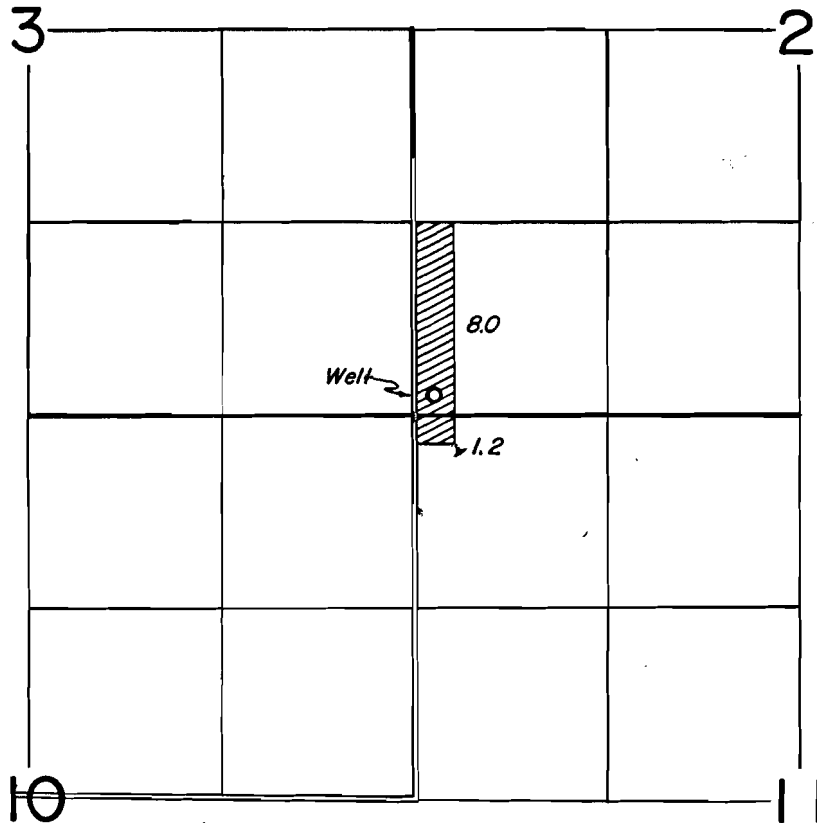

Well Loc.: 140' N. & 130' E. from the SW corner section 2

FINAL PROOF SURVEY
UNDER

Application No. G-8327 Permit No. G-7770
IN NAME OF

Ted & Barbara Struck

Surveyed Oct. 13, 1979, by AB