


T.16S.R.IW.W.M.

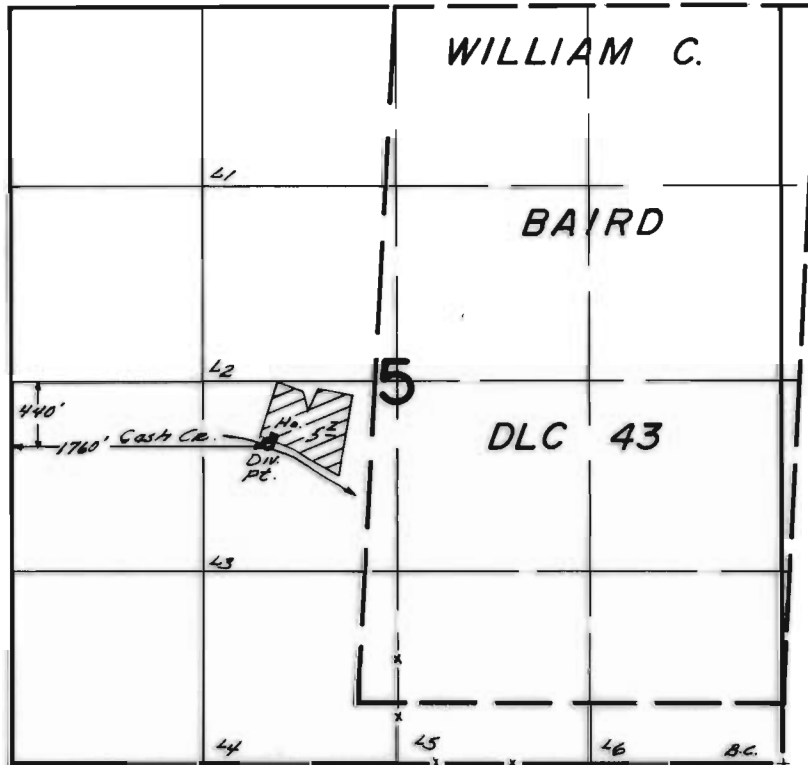

FINAL PROOF SURVEY UNDER

Application No. 47830 Permit No. 35853
IN NAME OF

NOEL & PATRICIA BERKELEY

Surveyed May 16 1979, by S.C. BROWN