


T.18S. R.7W. W.M.

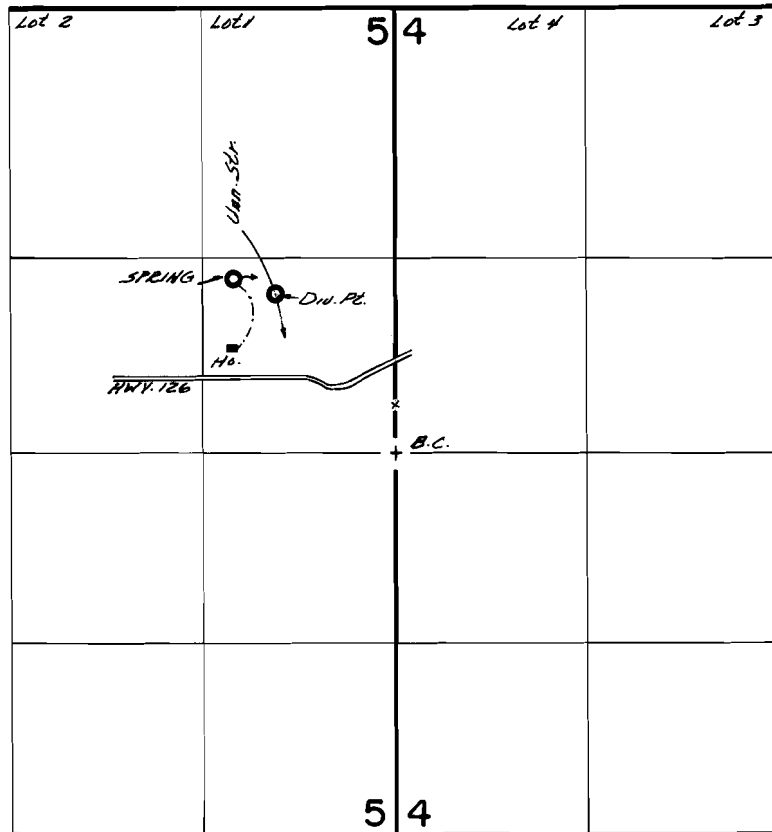

SPRING LOC. - 1200' N. & 1100' W. } BOTH FROM E 1/4 COR. SEC. 5
UNN. STR. DIV. - 1100' N. & 830' W. }

FINAL PROOF SURVEY
UNDER

Application No. **57689**. Permit No. **43388**.....
IN NAME OF

.....**PHYLLIS C. MAXEY**.....

Surveyed **June. 26. 1979.**, by **S.C. BROWN**.....