


T.18S.R.7W.W.M.

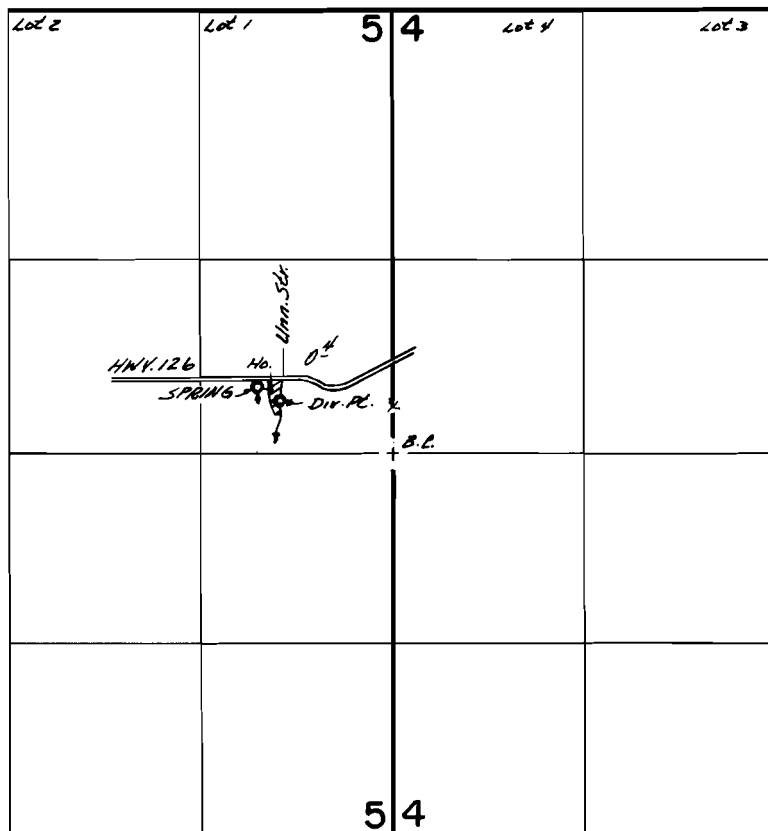

SPRING LOC. - 450' N & 940' W. } BOTH FROM E 1/4 COR. SEC. 5  
Umn. Sec. DIV. - 350' N & 800' W. }

**FINAL PROOF SURVEY**  
UNDER

Application No. 5.7.756. Permit No. 43605.....  
IN NAME OF

THOMAS W. & TERRY C. DEAN.....

Surveyed June. 26 1979., by S.C. BROWN.....