


T.16S.,R.5W.,W.M.

SECTION 18

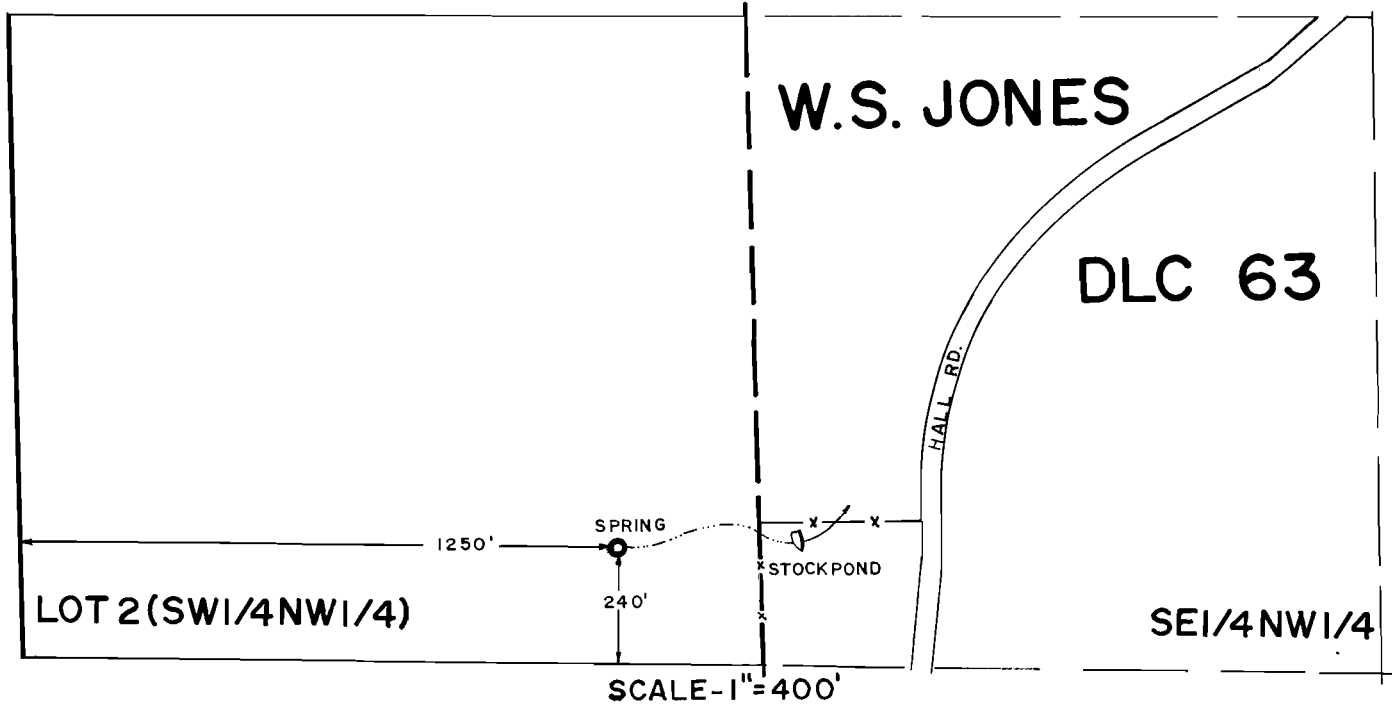

FINAL PROOF SURVEY
UNDER

Application No. 57.713 Permit No. 43861.....
IN NAME OF

HAROLD A. BALTER.....

Surveyed May 15, 1979, by S.C. BROWN.....