


T. 9 S., R. 1 & 2 E., W.M.

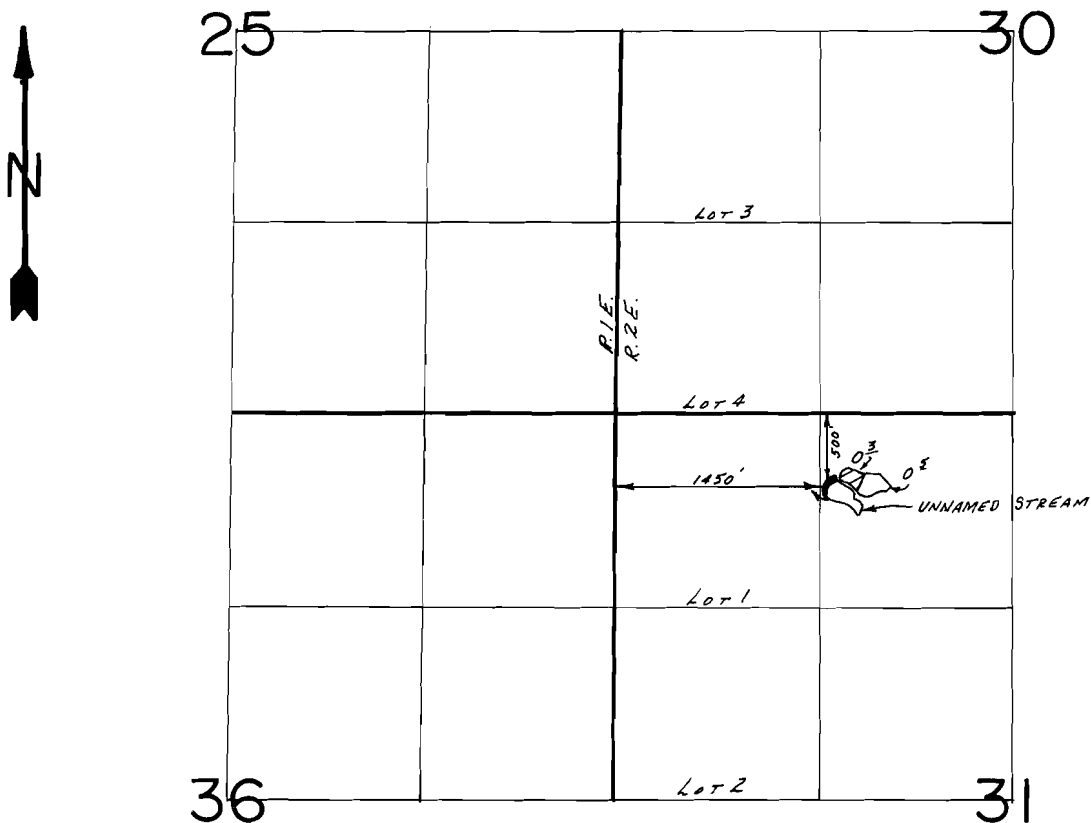

SCALE: 1"=1320'

FINAL PROOF SURVEY

UNDER

R-59827 R-8155
Application No. 59828 Permit No. 44955
IN NAME OF

RICHARD LINDEMANN

Surveyed Apr. 25, 1984, by L.M. TOLL