


# T.11S., R.2W., W.M.

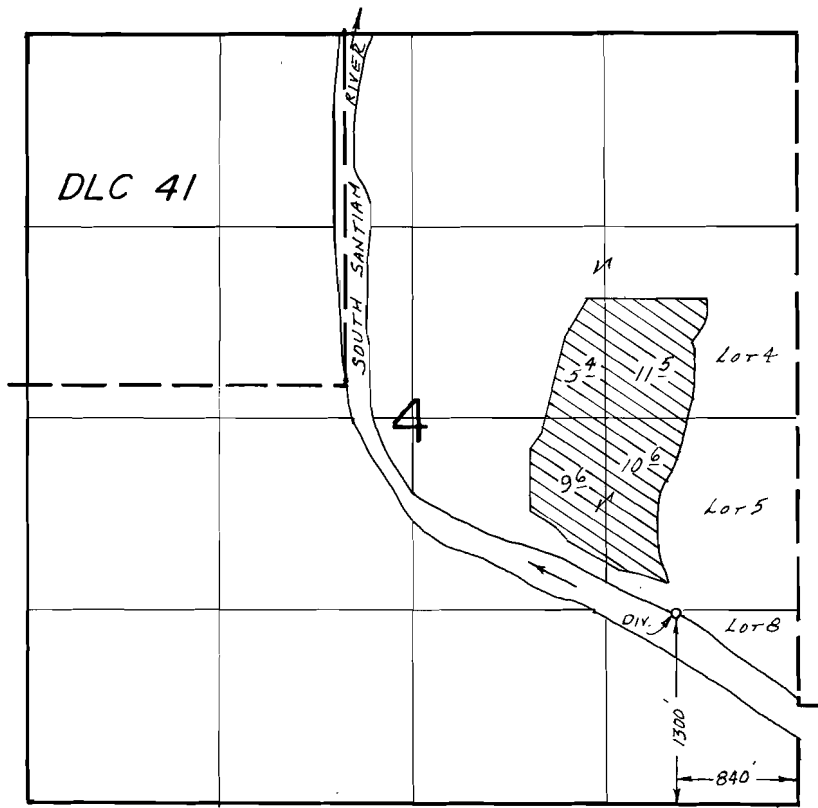

SCALE: 1" = 1320'

## FINAL PROOF SURVEY UNDER

Application No. 59948. Permit No. 45023.....  
IN NAME OF

.....SHUMAKER FARMS.....

Surveyed Oct. 3..... 19.85, by T.M. WARREN.....