


T.9S., R.1W.&E., W.M.

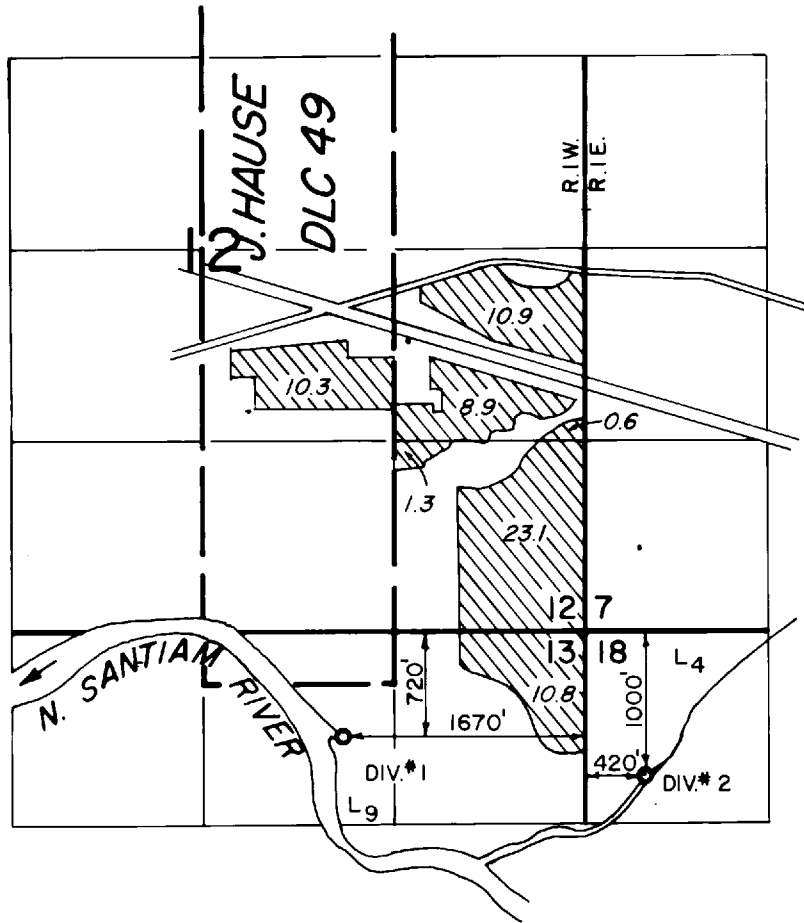

FINAL PROOF SURVEY
UNDER

Application No. 55568 Permit No. 41649
IN NAME OF

Augustin J. & Marie A. Kirsch

Surveyed OCT. 4, 1979, by [Signature]