


T. 4S., R. 2W., W.M.

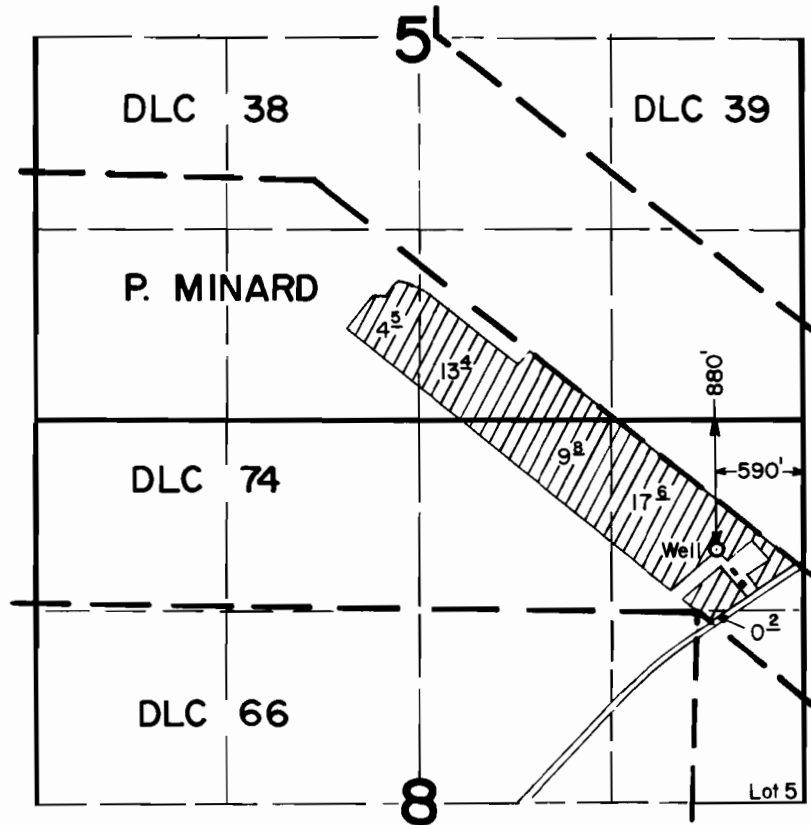

FINAL PROOF SURVEY UNDER

Application No. G-6929 Permit No. G-6447

IN NAME OF

JOHN MCKAY

Surveyed Aug. 28, 1979, by S.C. BROWN