


MAP OF
WATER PERMIT SURVEY
 IN SEC. 16 T29S R12W WIL. MER.
 FOR
M. J. NICHOLS
 SCALE 1" = 500' E.L. VINTON
 MAY 1924

STATE ENGINEER
 RECEIVED

MAY 10 1924

SALEM, OREGON

Application No. 9521
 Permit No. 6298

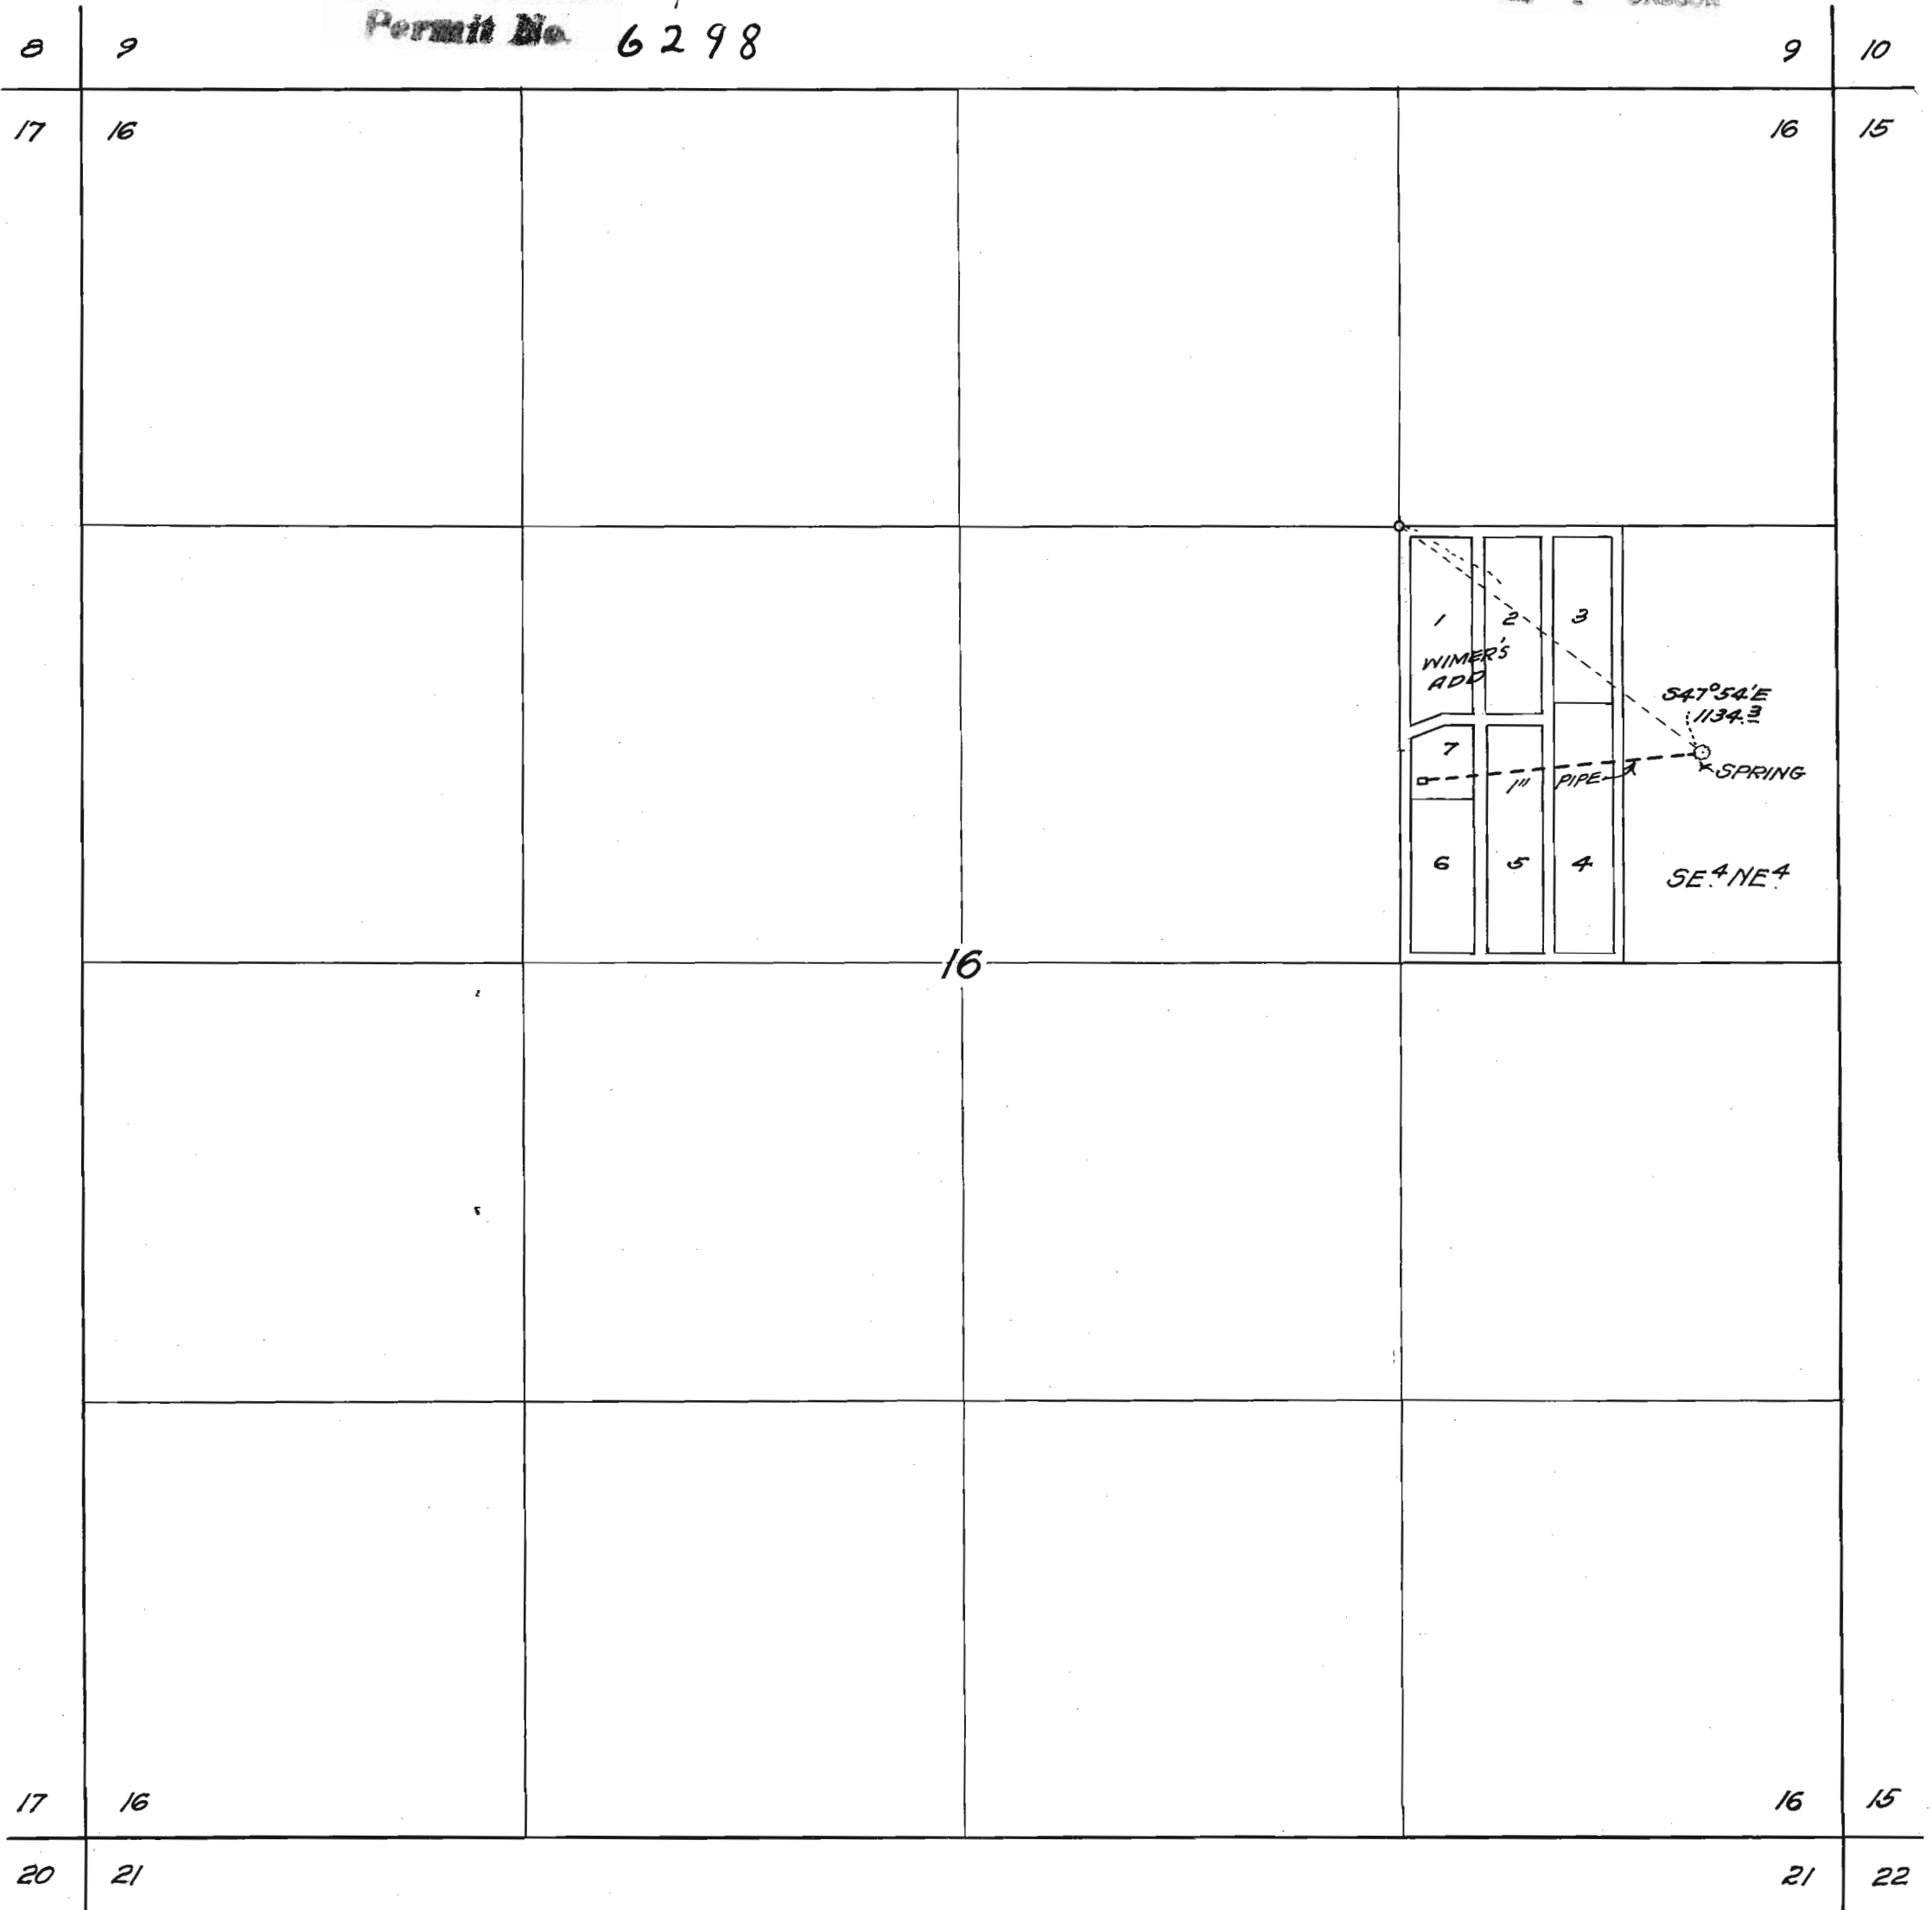

I, E.L. Vinton of Coquille Coos Co, Oregon, do hereby
 certify that this map was made from notes taken dur-
 ing an actual survey made under my immediate super-
 vision on May 13th 1924, and that it correctly rep-
 resents the works described in the accompanying
 application, together with the location of streams and
 other ditches in the immediate vicinity.

E.L. Vinton
 Registered Professional Engineer.

Oregon No. 164

Date of registration - Nov. 8th 1919