


T.3N.R.10W.W.M.

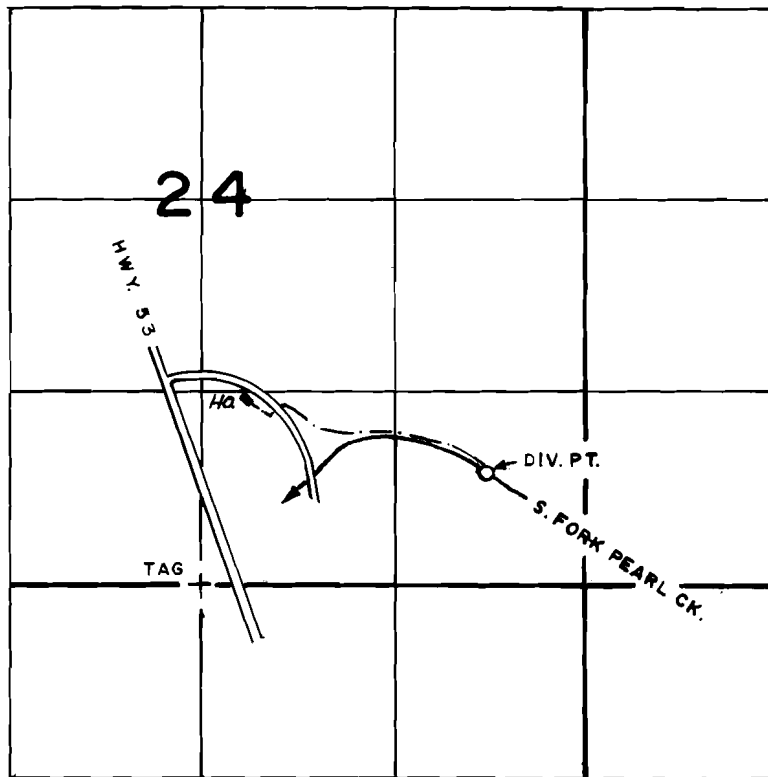

DIV. PT. LOC. 750' N. & 1950' E. FROM S. 1/4 COR. SEC. 24

FINAL PROOF SURVEY
UNDER

Application No. 58331. Permit No. 43920.....
IN NAME OF

GLENN EASOM

Surveyed AUG 16, 1979, by R.G. MUCKEN.....