


T.2N.R.3W.W.M.

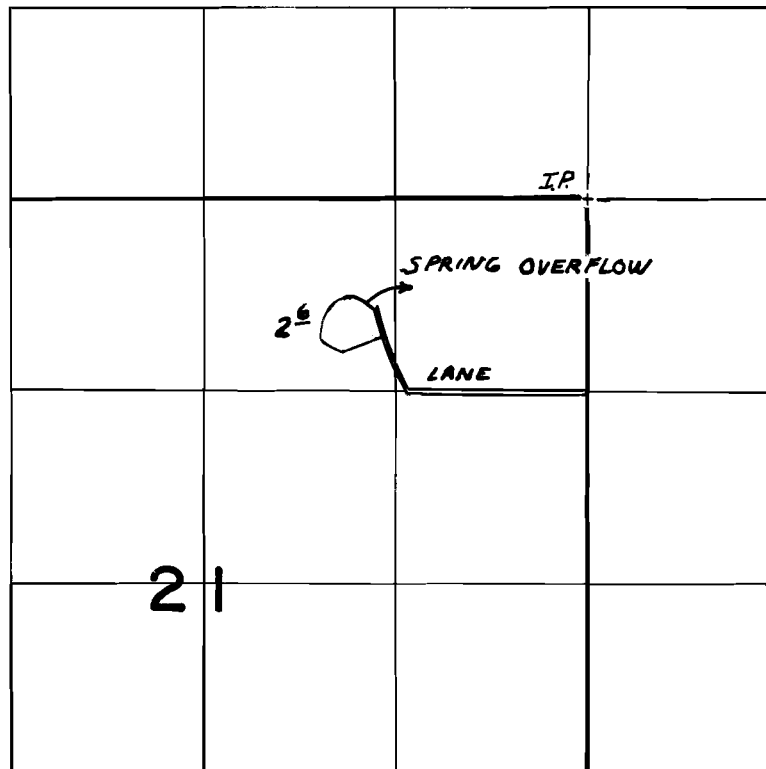

DIV. PT. LOC.: 720' S. & 1520' W. FROM N.E. COR. SEC. 21

FINAL PROOF SURVEY

UNDER

R-52571 R-6088
Application No. 52572 Permit No. 37506....
IN NAME OF

COLUMBIA RIVER GIRL SCOUT COUNCIL

Surveyed 10-23-1979, by R.G. MUCKEN.