


# T.1N.R.3W.W.M.

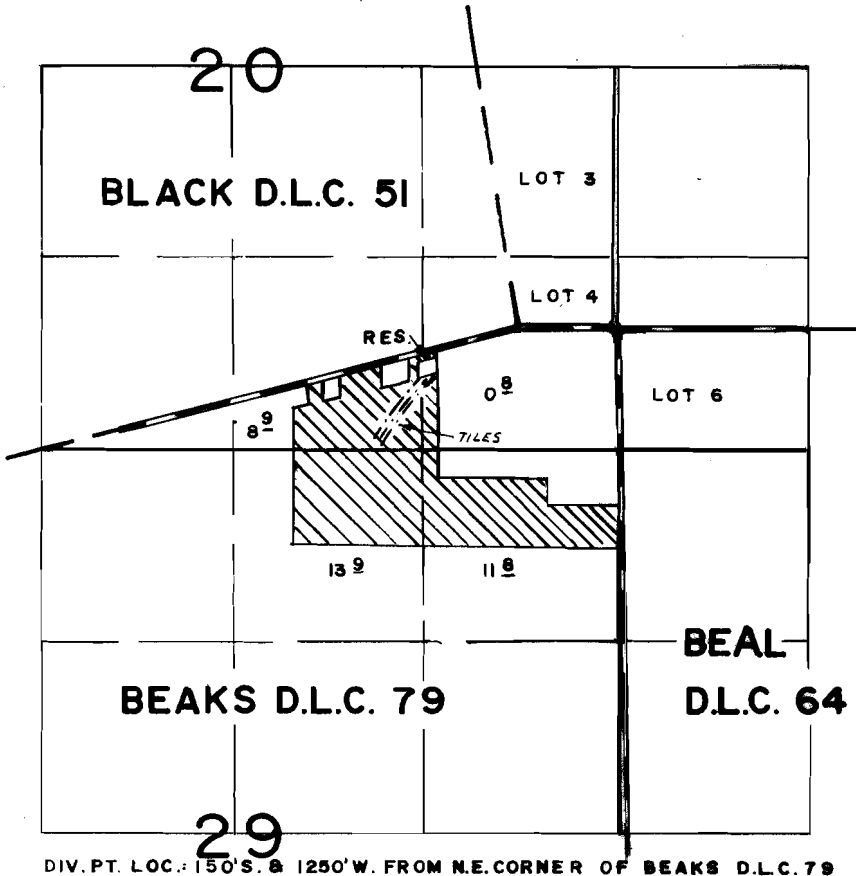

## FINAL PROOF SURVEY UNDER

53788

40387

Application No. R.:53729 Permit No. R.:6433....

IN NAME OF

.....WALT. DUYCK.....

Surveyed ..MAY..1... 19.7.9, by R.G.MUCKEN.....