


T.I.S.R.3W.W.M.

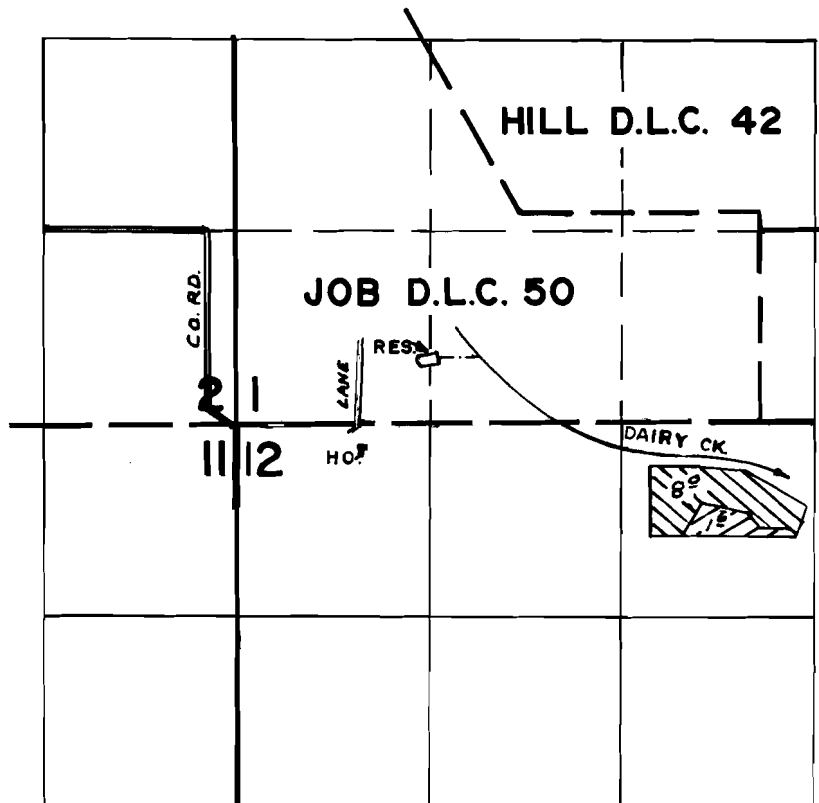

DIV. PT. LOCATED 450' N. & 1400' E. FROM SW. COR. SEC. 1

-  PRIMARY
-  SUPPLEMENTAL

FINAL PROOF SURVEY UNDER

R-54592 R-6526

Application No. ~~54593~~ Permit No. ~~40913~~.....

IN NAME OF

EDMUND DUYCK

Surveyed APR. 24. 19.79, by R.G. MUCKEN.....