


T.I.S.R.3W.W.M.

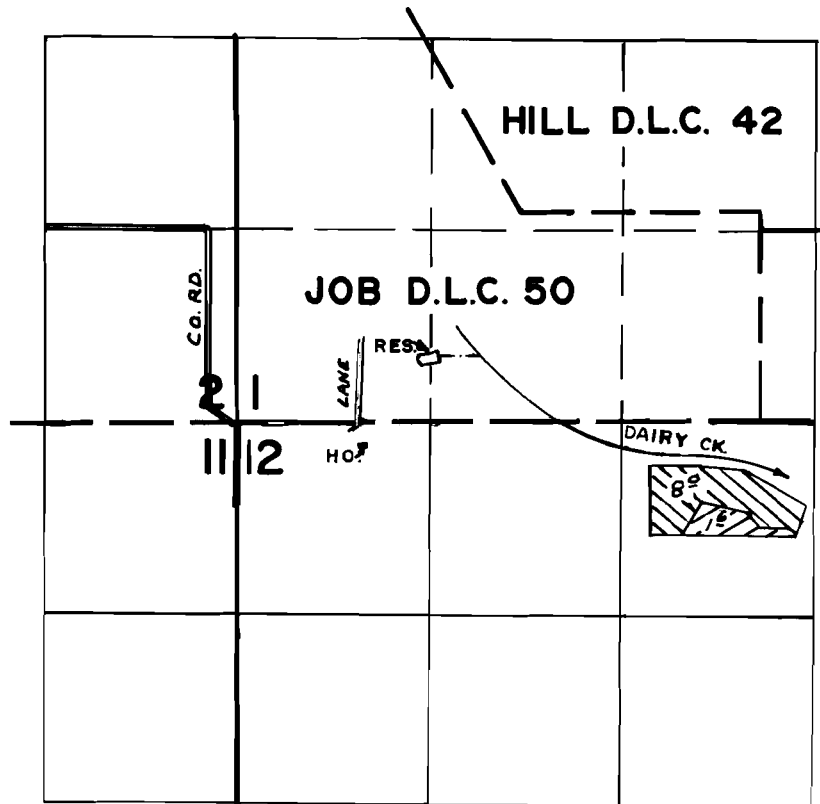

DIV. PT. LOCATED 450'M. @ 1400'E. FROM SW. COR. SEC. 1

 PRIMARY
 SUPPLEMENTAL

FINAL PROOF SURVEY UNDER

R-54592 R-6526
Application No. ~~54593~~. Permit No. 40913.....
IN NAME OF

.....**EDMUND DUYCK**.....

Surveyed APR. 24... 19.7.9, by R.G. MUCKEN...