


T.1S.R3W.W.M.

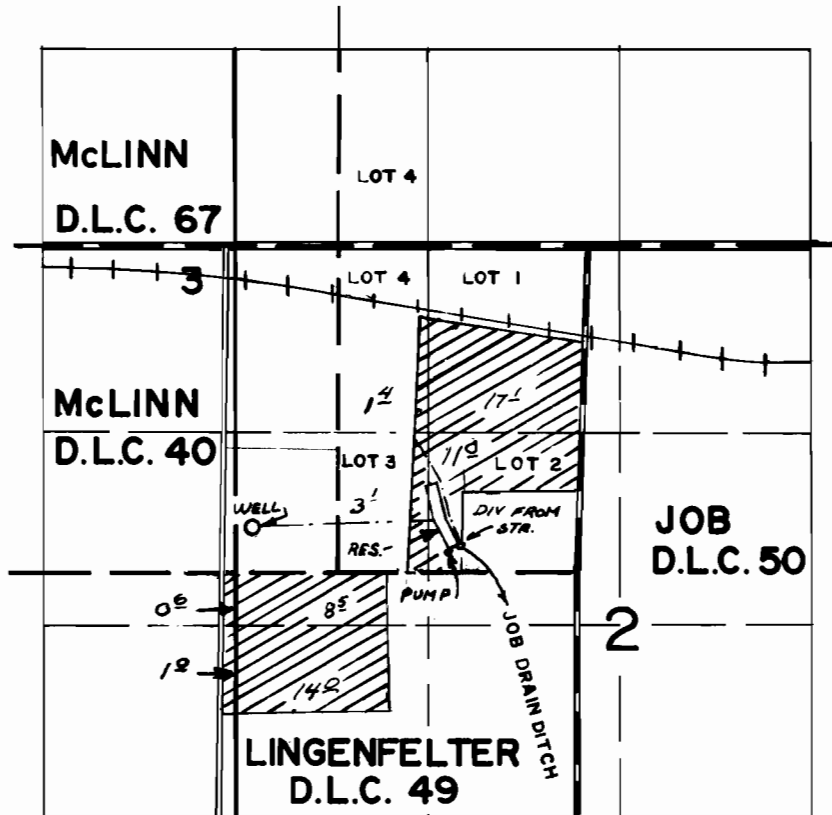

DIV. FROM RES. LOC: 130'N. & 750'E. FROM S.E. COR. McLINN D.L.C. 40
 DIV. FROM STREAM LOC: 150'N. & 850' E. FROM S.E. COR. McLINN D.L.C. 40
 WELL LOC.: 300'N. & 570'W. FROM S.E. COR. McLINN D.L.C. 40

FINAL PROOF SURVEY UNDER

G-8055 G-7461
 Application No. 55730... Permit No. 41740.....
 IN NAME OF

.....EDMUND DUYCK.....

Surveyed APR. 24. 19.79, by R.G.MUCKEN.....