


T.1N.R.4W.W.M.

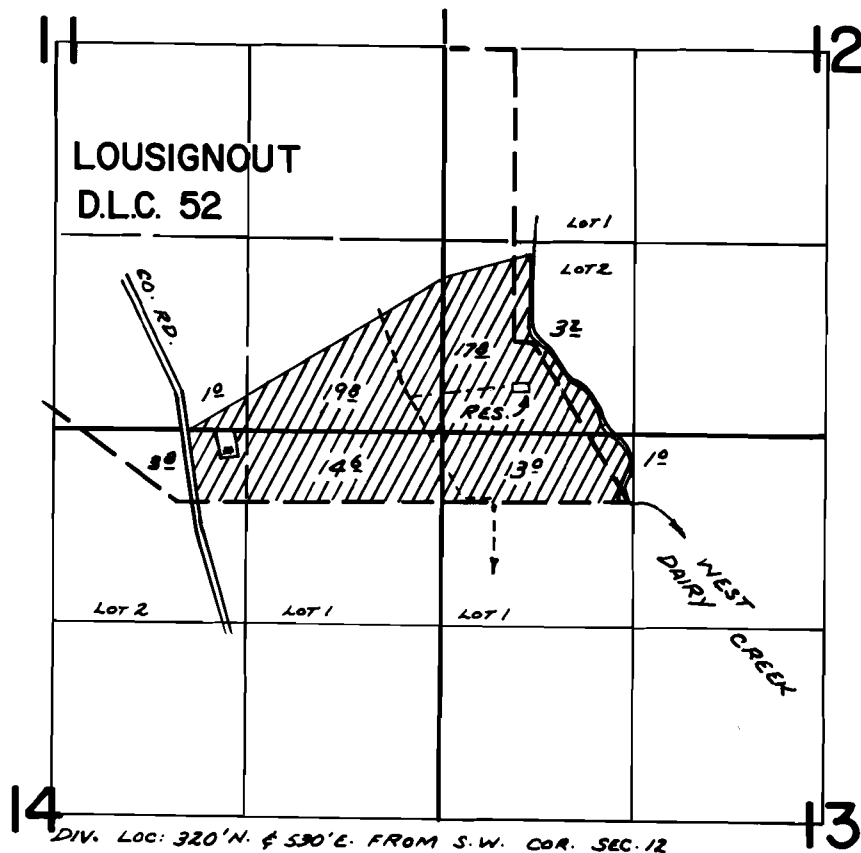

FINAL PROOF SURVEY UNDER

Application No. ~~56963~~ ^{R-56464} Permit No. ~~42497~~ ^{R-6737}
IN NAME OF

.....HENRY...&...GERTRUDE...LANDAUER

Surveyed APR. 27, 1979., by R. MUCKEN