


T.1N.R.4W.W.M.

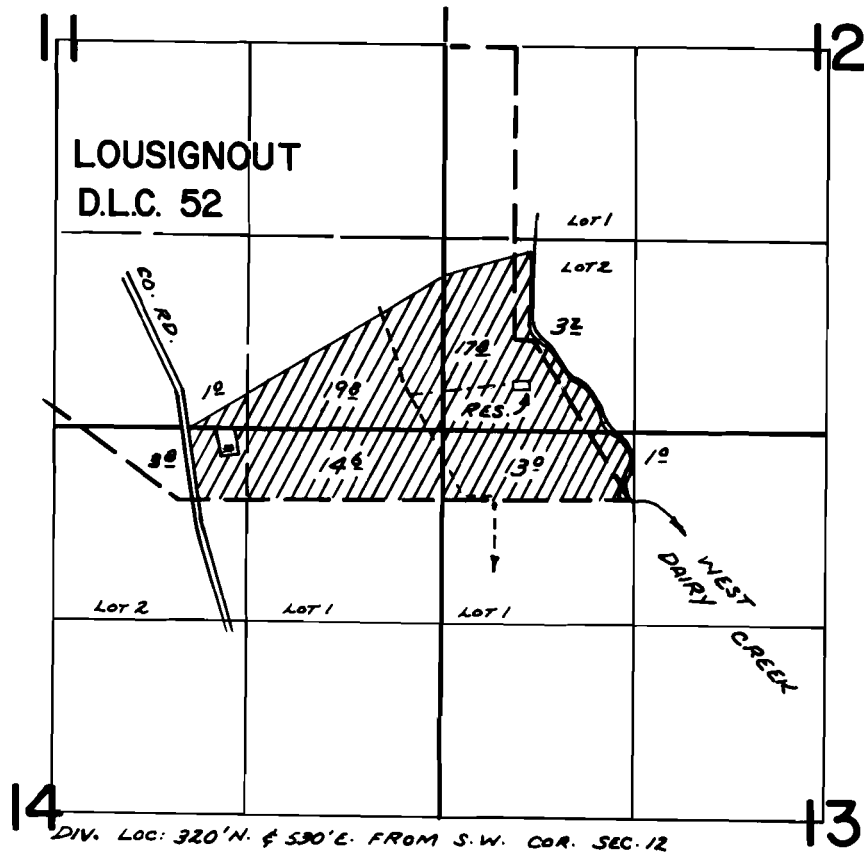

FINAL PROOF SURVEY

UNDER

Application No. ~~56463~~ ^{R-56464} Permit No. ~~42497~~ ^{R-6737}
IN NAME OF

.....HENRY...&...GERTRUDE...LANDAUER

Surveyed APR. 27. 1977., by R. MUCKEN