


T.2N.R.3W.W.M.

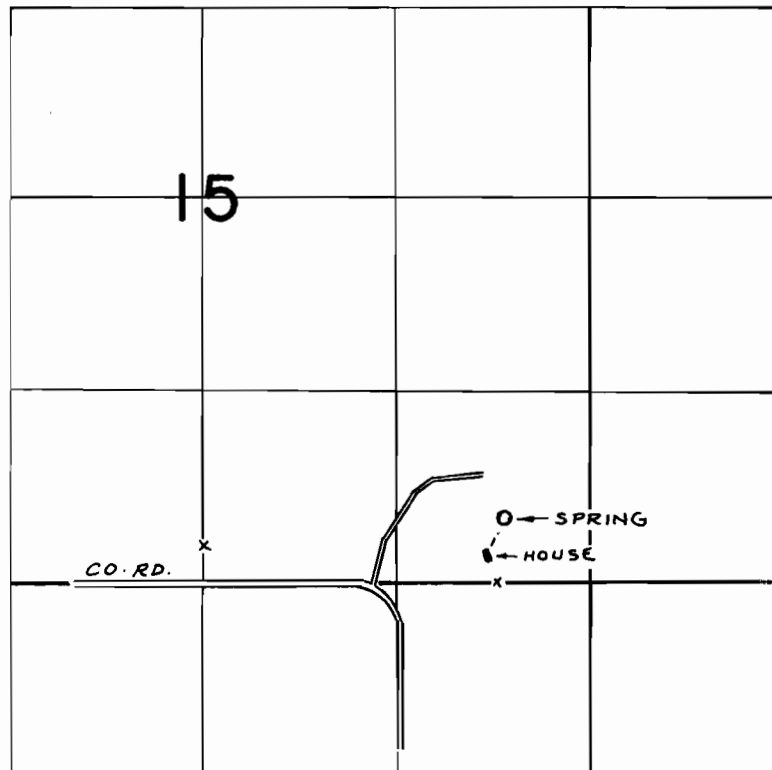

SPRING LOC: 430' N. & 2060' E. FROM S $\frac{1}{4}$ COR. SEC. 15

FINAL PROOF SURVEY
UNDER

Application No. 57113 Permit No. 42990
IN NAME OF

WILLIAM H. WOTTLIN

Surveyed NOV. 8, 1979, by R. MUCKEN