


T. 11 S., R. 6 W., W.M.

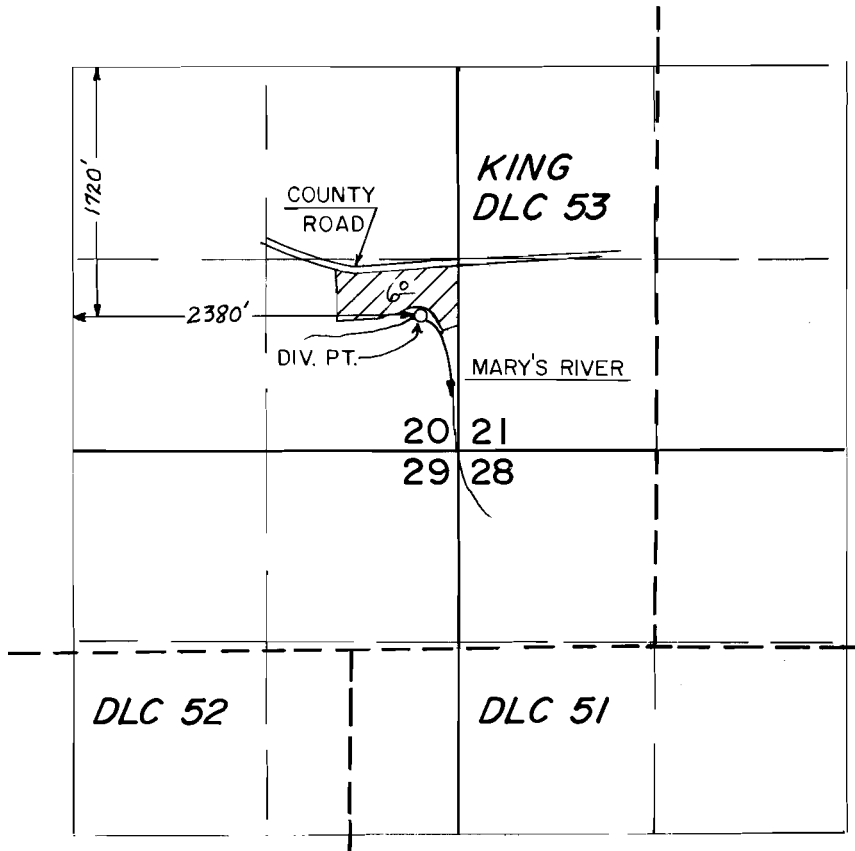

SCALE: 1" = 1320'

FINAL PROOF SURVEY
UNDER

Application No. 53142 Permit No. 39925

IN NAME OF

DEAN A. MALENCIK

Surveyed AUG. 3 1984, by L.M. TOLL