


T.11S., R.4W., W.M.

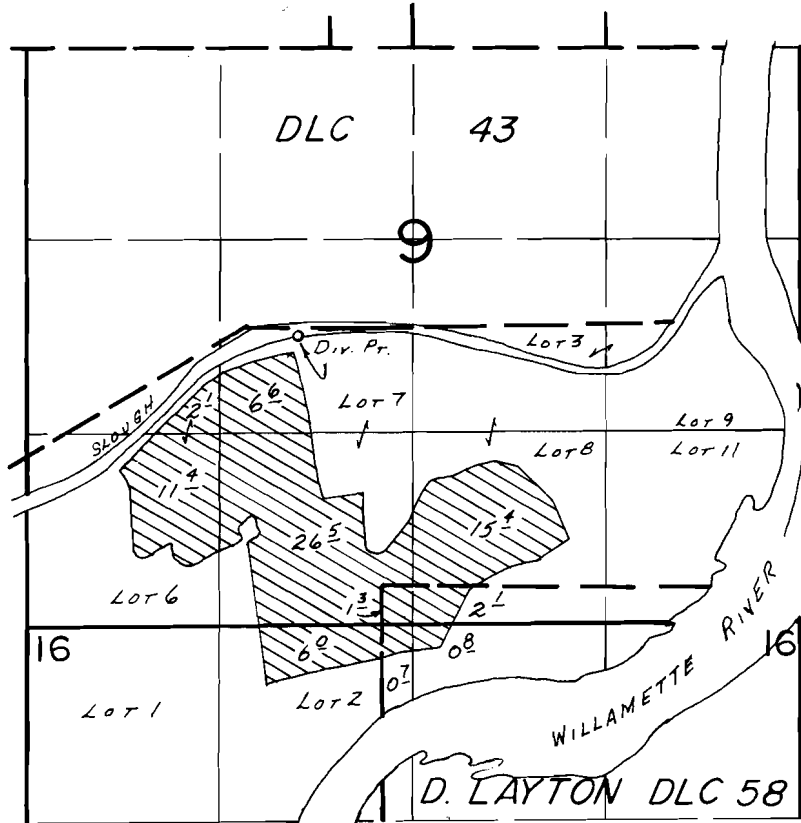

DIV. Pr. Loc.: 1980 N. & 1850 E. FROM SW COR. SEC. 9.

SCALE: 1" = 1320'

FINAL PROOF SURVEY UNDER

Application No. 55444. Permit No. 41585.....
IN NAME OF

..... EDWARD J. REYNOLDS

Surveyed July..10.... 19.84, by L.M.T.O.L.L.....