


T.13S., R.6W., W.M.

Section 6

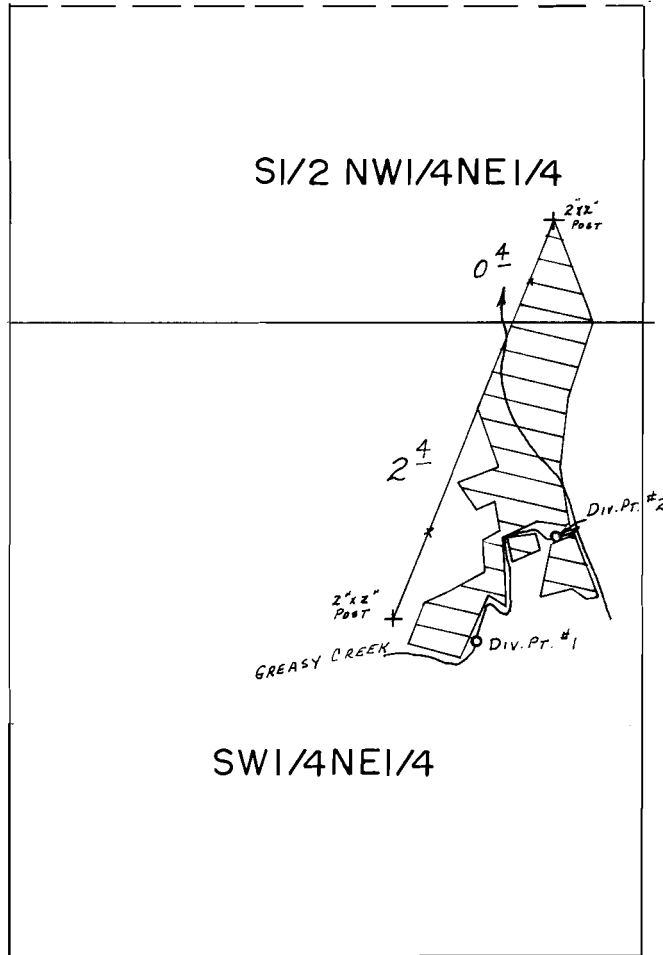

Div. Pts. Loc.: #1- 650' N. & 970' E., #2- 870' N. & 1140' E., BOTH FROM CENTER 1/4 COR. SEC. 6.

SCALE: 1" = 400'

**FINAL PROOF SURVEY**  
UNDER

Application No. 57637... Permit No. 43389.....  
IN NAME OF

MELVIN O. & ESTHER M. CASTLE

Surveyed June 13... 1983, by L.M. TOLL.....  
July 26 1984