


T.11S., R.6W., W.M.

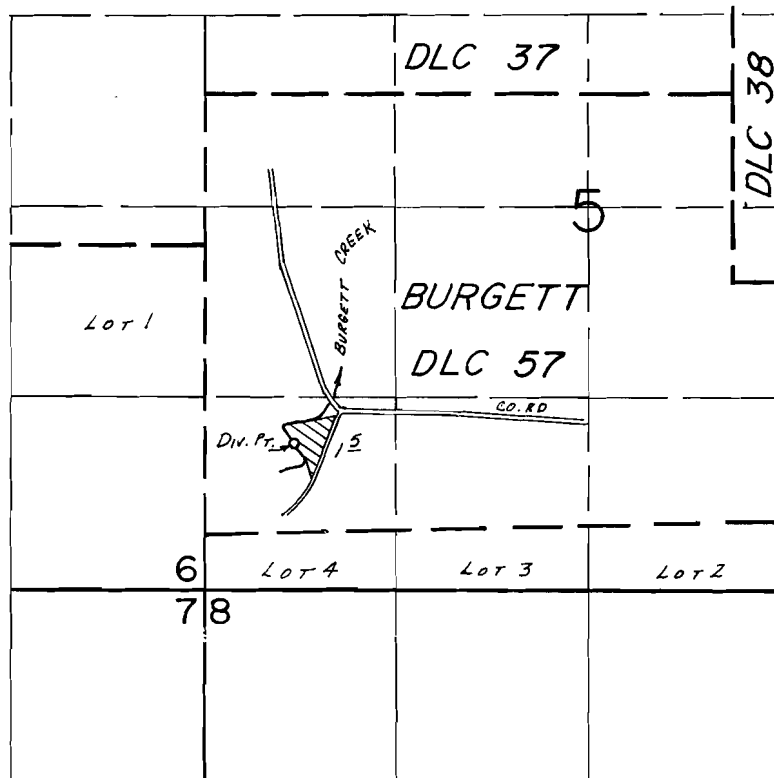

DIV. PT. LOC.: 1000' N & 620' E. FROM SW COR. SEC. 5.

SCALE: 1" = 1320'

FINAL PROOF SURVEY UNDER

Application No. 61521... Permit No. 45705.....
IN NAME OF

OWEN W. & LOIS M. WEBSTER..

Surveyed July 25, 1984, by L.M. TOLL.....