


T.3S.R.1E.W.M.

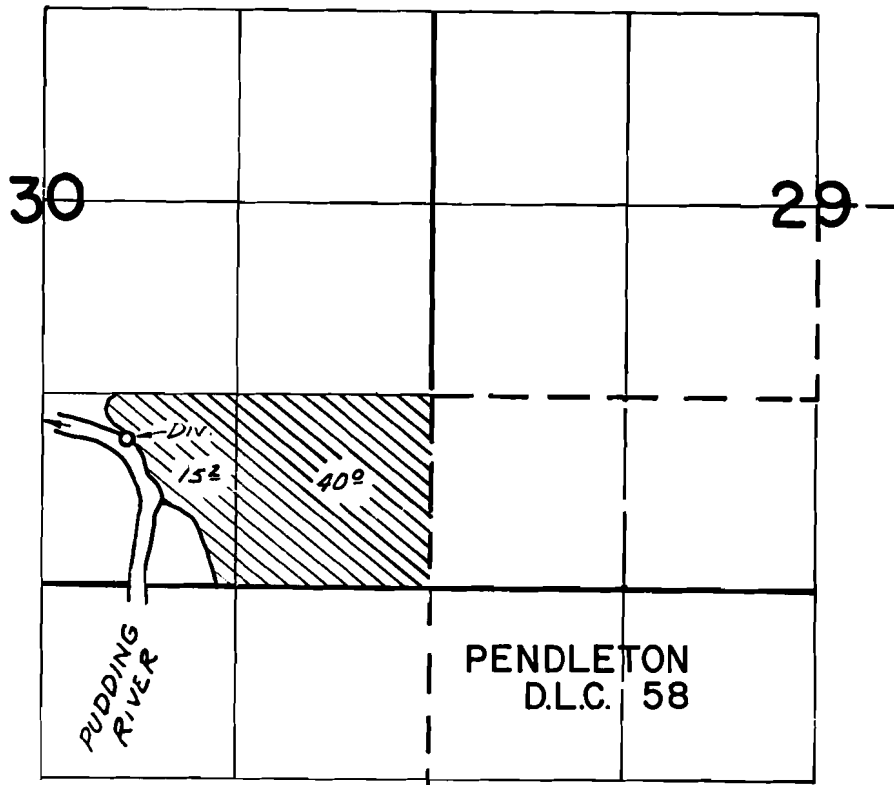

DIV. PT. LOC: 1000' N. & 2080' W. FROM S.E. COR. SEC. 30

FINAL PROOF SURVEY

UNDER

Application No. 51822. Permit No. 39026.....
IN NAME OF

.....LeRoy E. Beals.....

Surveyed .MAR. 4 1980., by .R. MUCKEN..