


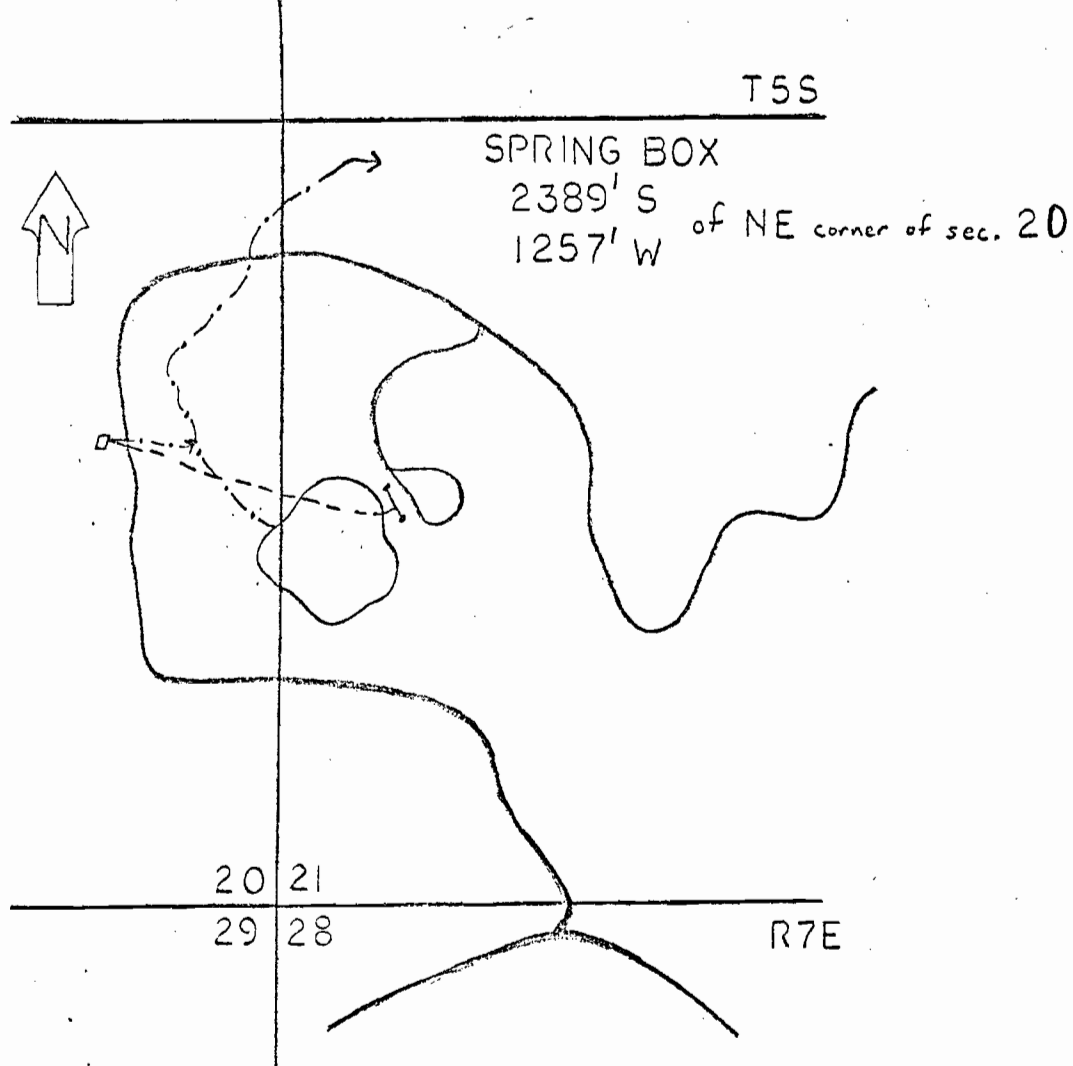


LEGEND

- ROAD
- PIPE
- ▣ SPRING BOX
- - - CREEK

SCALE
4" = 1 MILE

Application No. 64322
Permit No. 48734

HIDEAWAY LAKE SPRING DEVELOPMENT
CLACKAMAS RANGER DISTRICT

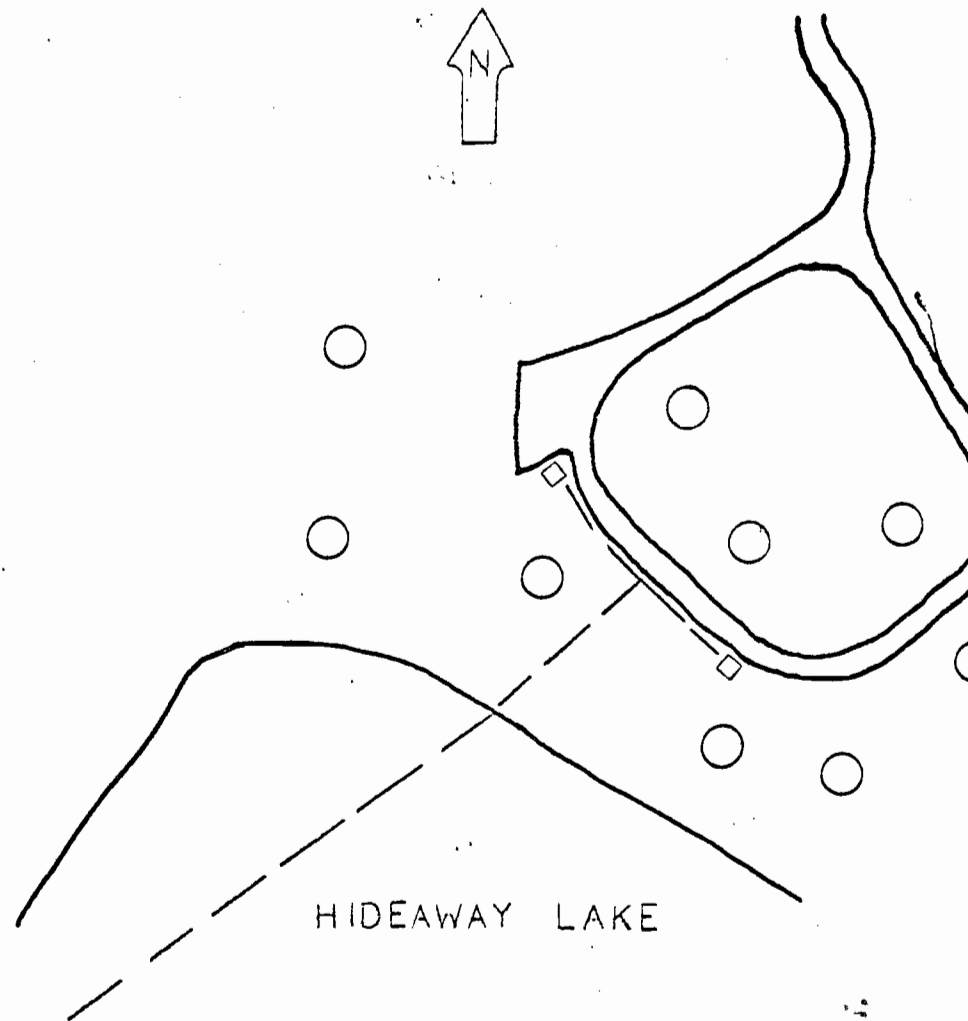

LEGEND

- == ROAD
- CAMP SITE
- PIPE
- ▣ FAUCET

SCALE IN FEET
0 150

RECEIVED

OCT 11 1982

WATER RESOURCES
SALEM, OREGON