


SECTION

2

SE 1/4, NE 1/4

TOWNSHIP 5 S., RANGE 5 E., W. M.

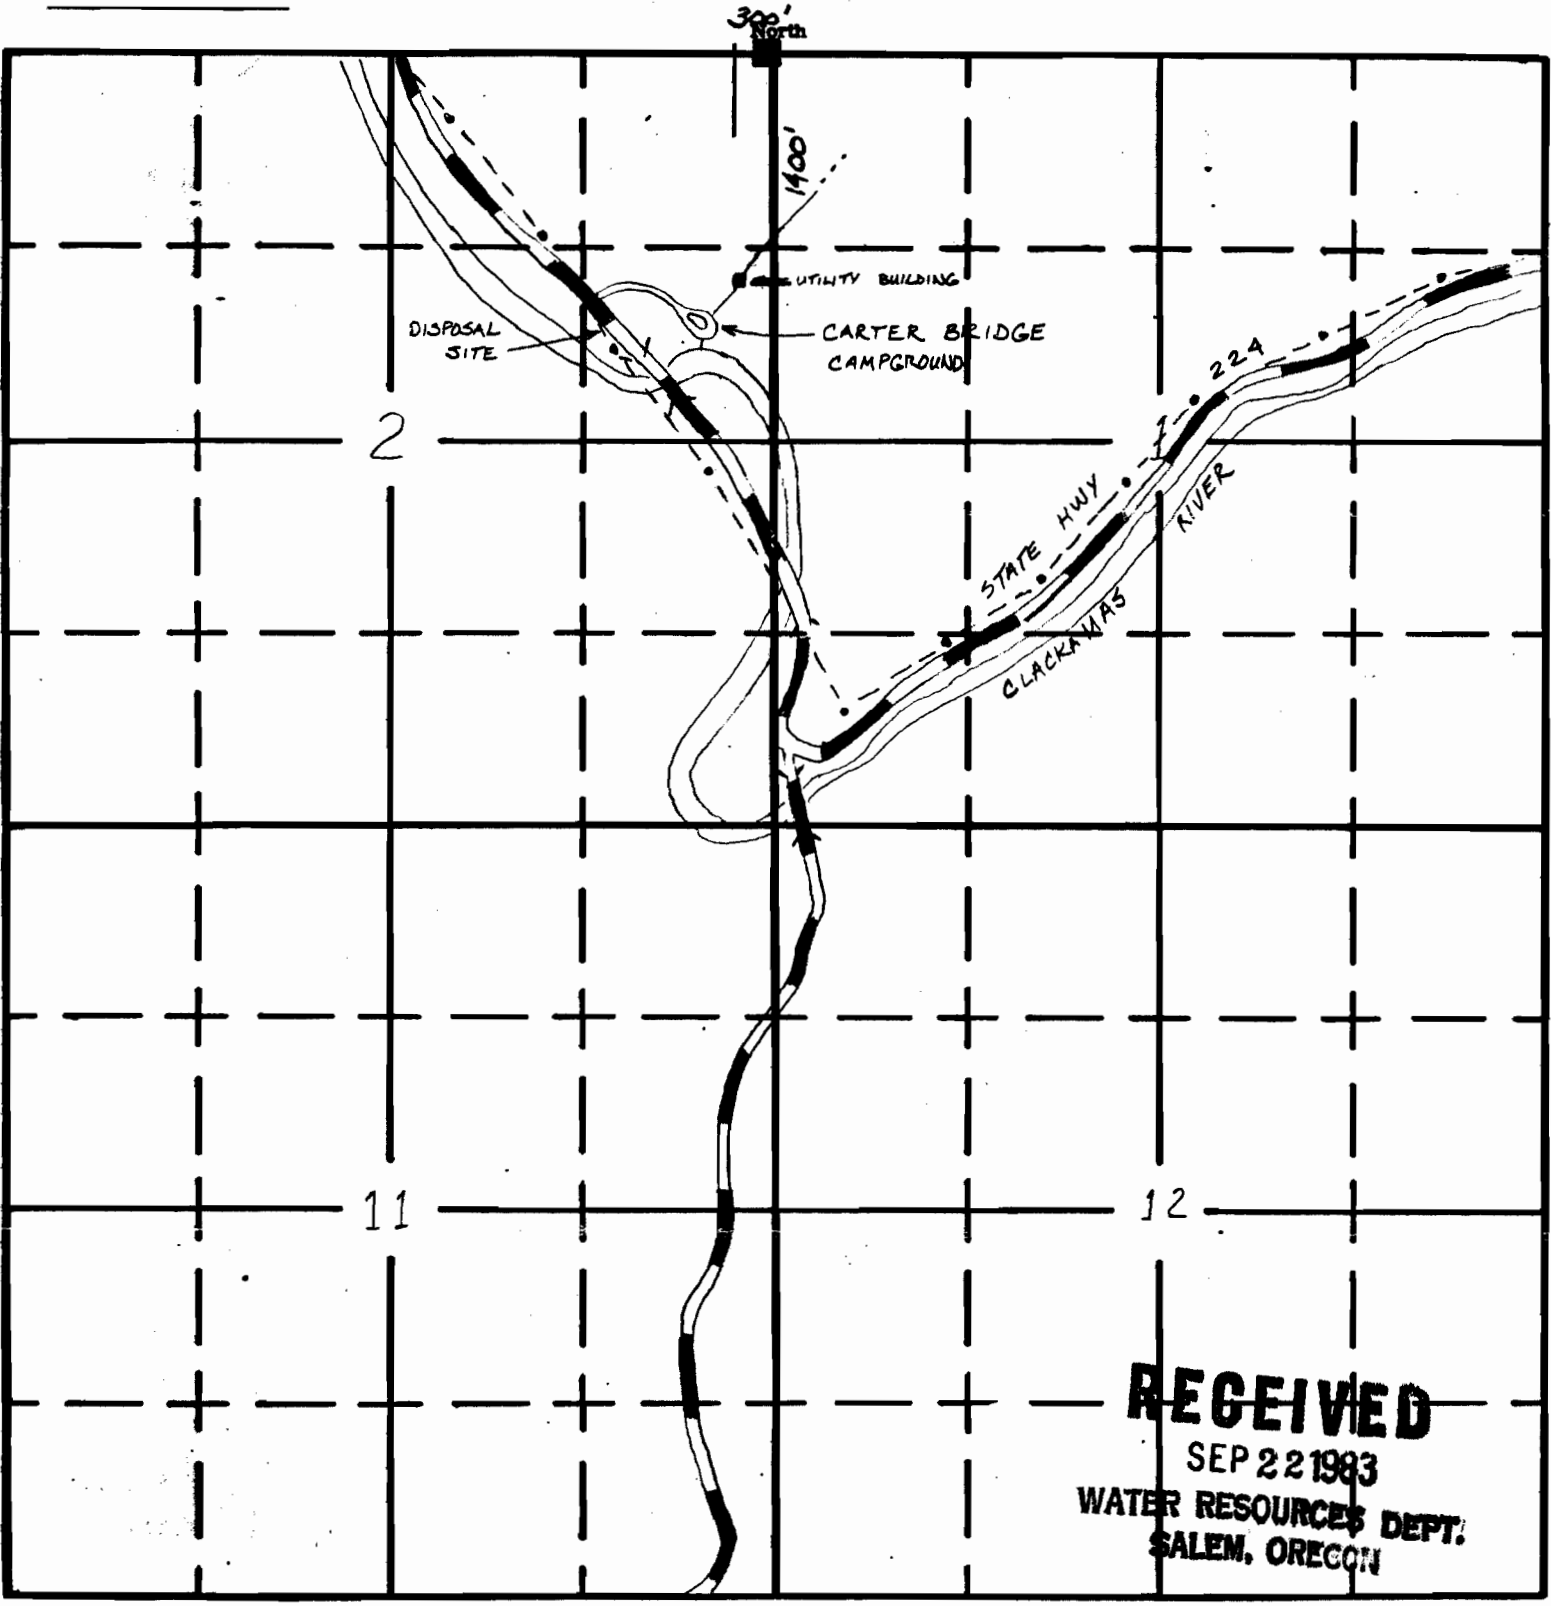

RECEIVED
 SEP 22 1983
 WATER RESOURCES DEPT.
 SALEM, OREGON

Application No. 66662
 Permit No. 48741