




T. 5 S., R. 1 E., W.M.

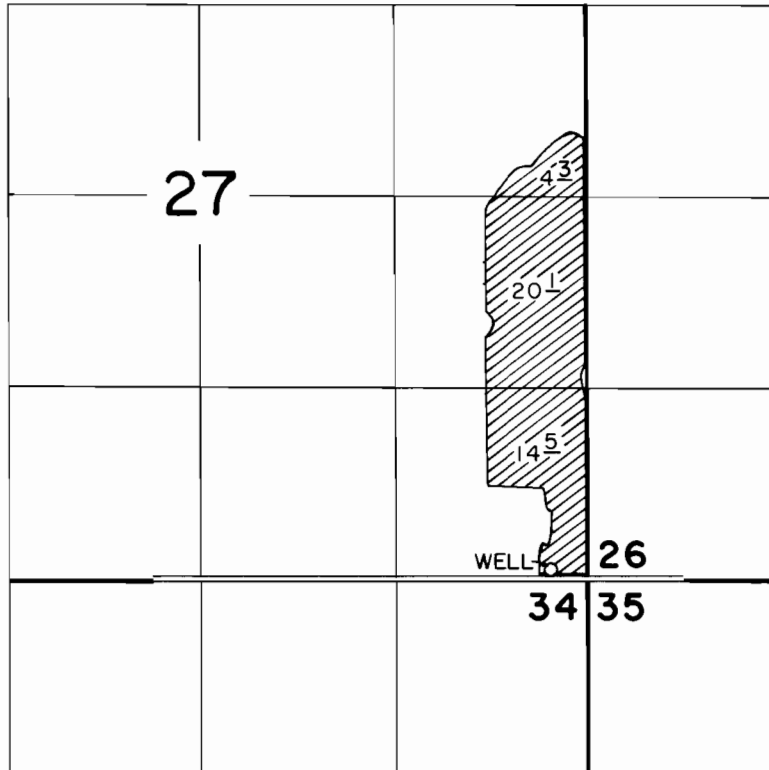

WELL LOC: 50' N. & 250' W. FROM THE SE. CORNER SECTION 27

SCALE: 1" = 1320'

**FINAL PROOF SURVEY**  
UNDER

Application No. G-8004 Permit No. G-7443...  
IN NAME OF

.....**BERNARD KIMLINGER**.....

Surveyed JUNE 14, 1985, by T. WARREN.....