


# T4S. R1E. WM.

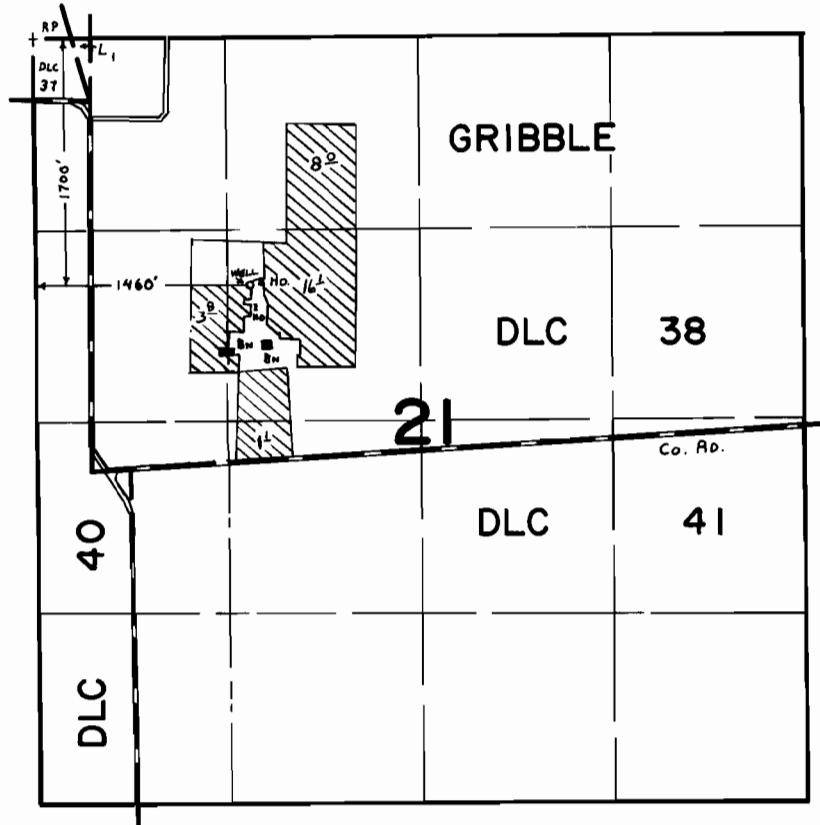

## FINAL PROOF SURVEY UNDER

Application No. G-8041 Permit No. G-7577  
IN NAME OF

STANLEY G. HALLGARTH

Surveyed SEPT. 27 1978, by C. L. HUGHES