


T. 5 S., R. 1 E., W. M.

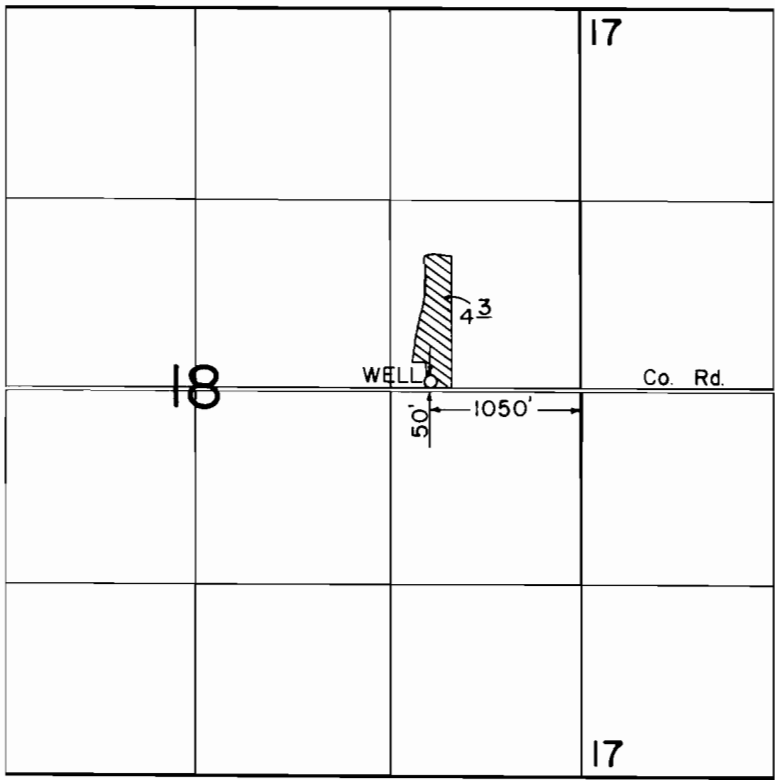

SCALE: 1" = 1320'

FINAL PROOF SURVEY UNDER

Application No. G-10000 Permit No. G-9089....
IN NAME OF

.....EDGAR WILSON JR.

Surveyed JUNE 25, 1985., by T. WARREN.....