


T. 4 S., R. 1 E., W. M.

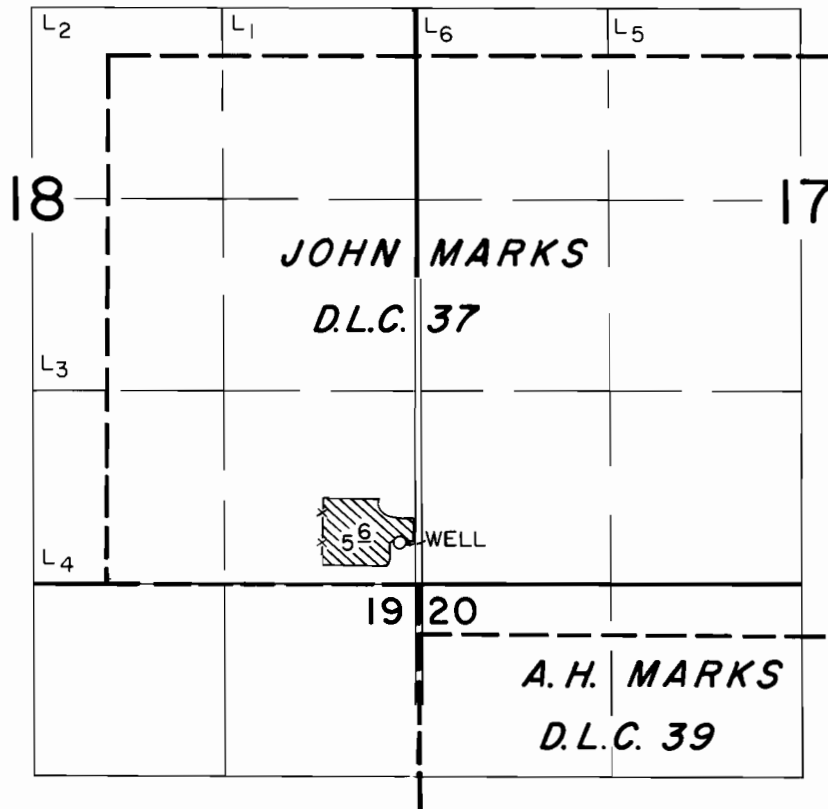

WELL LOC: 280' N. & 130' W. FROM THE SE. CORNER SECTION 18

SCALE: 1" = 1320'

FINAL PROOF SURVEY UNDER

Application No. G-10588 Permit No. G-9715
IN NAME OF

RICHARD KOCH

Surveyed JULY 17, 1985, by T. WARREN