


T. 5 S., R. 1 E., W. M.

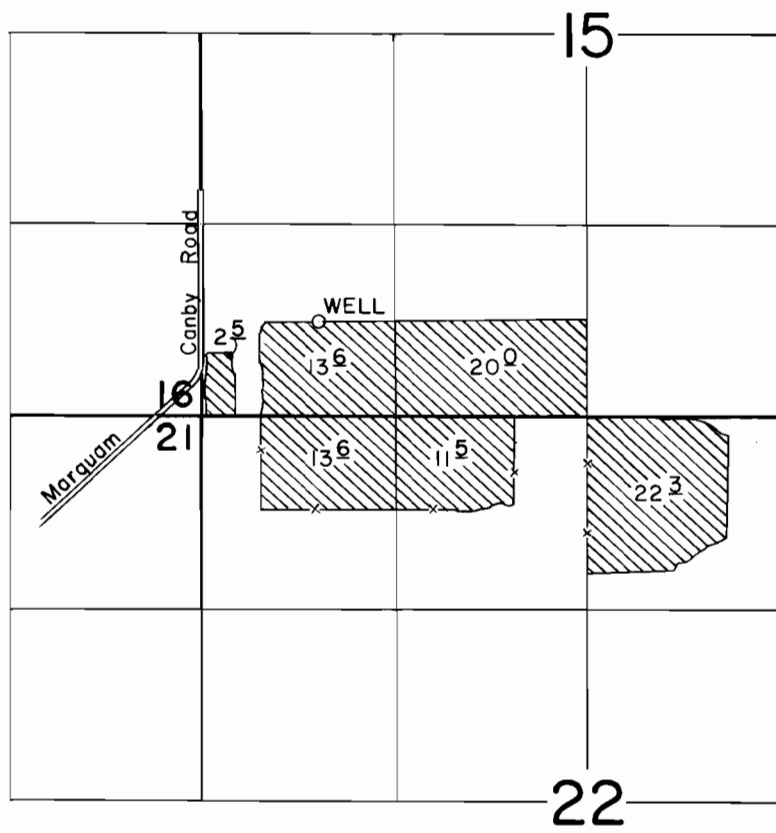

WELL LOC: 650' N. & 800' E. FROM THE SW CORNER SECTION 15

SCALE: 1" = 1320'

FINAL PROOF SURVEY UNDER

Application No. G-10913 Permit No. G-10134
IN NAME OF

DAVID G. SCHRIEVER

Surveyed JUNE 24, 1985, by T. WARREN