


T.24S.,R.5W.,W.M.

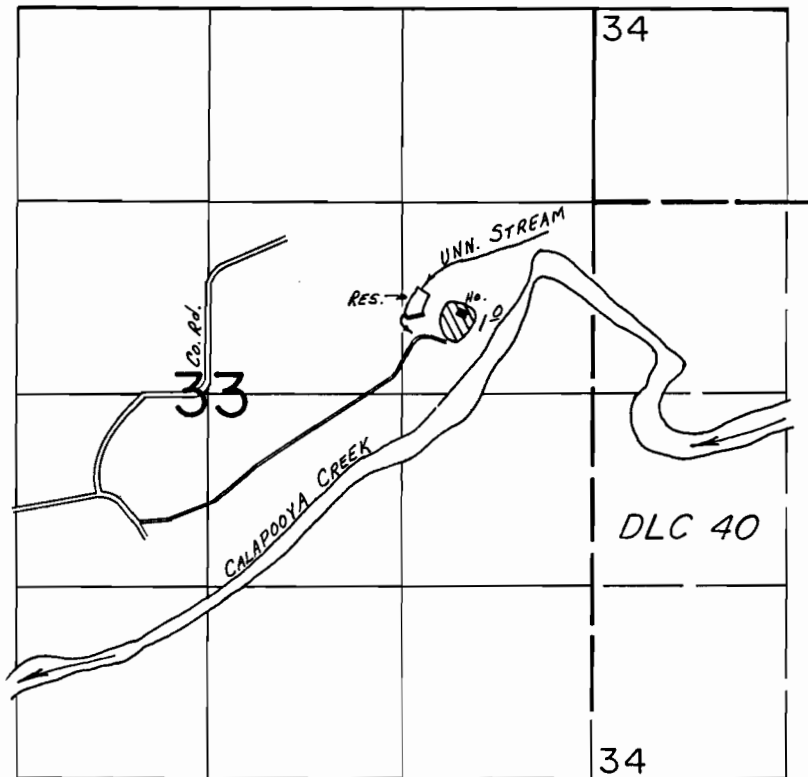

DAM LOC: 3180' N. & 1200' W. FROM SE COR. SEC. 33.

FINAL PROOF SURVEY
UNDER

R-52545 R-6380
Application No. 52546... Permit No. 39812.....
IN NAME OF

.....ROBERT H. & DIXIE HOGAN.....

Surveyed MAY 21... 1980, by J.S. DONALDSON