


Township 1S Range 10E

46459

N
A

Scale 4" = 1 Mile

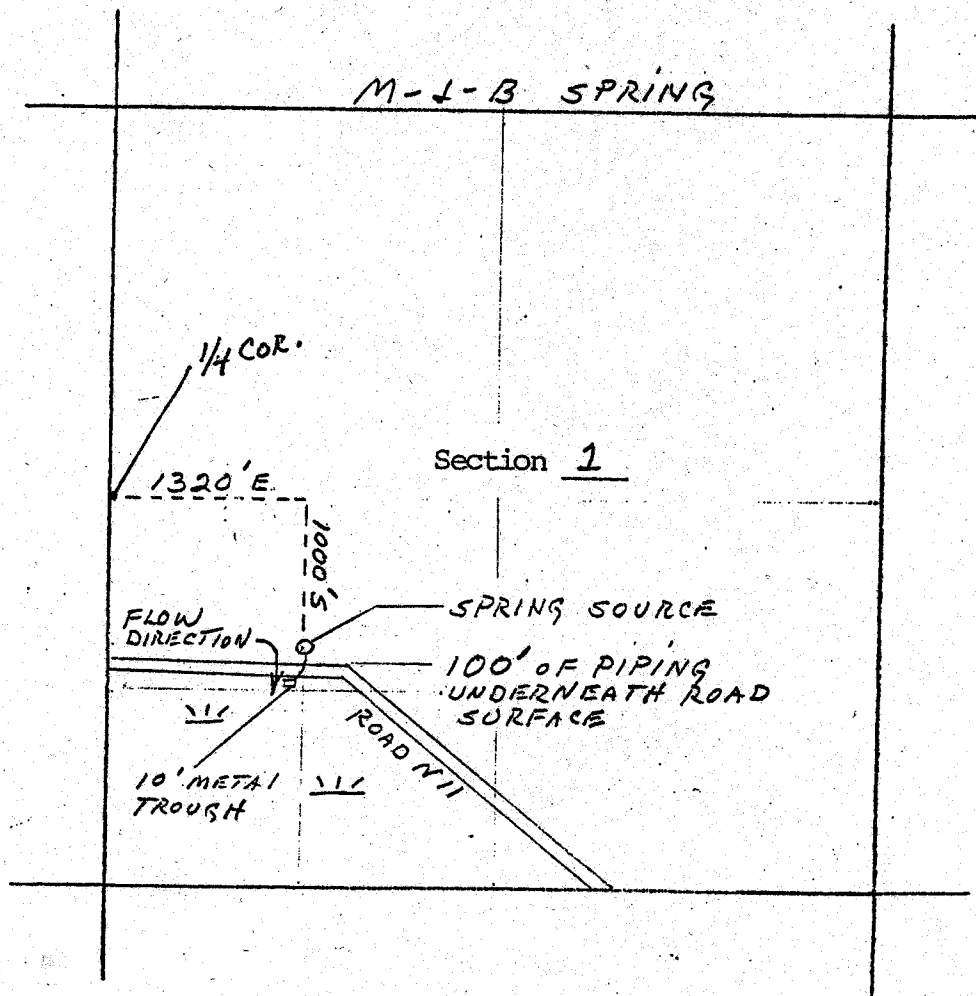

Application No. 61514

Permit No. 46459

RECEIVED

JUL 31 1981

WATER RESOURCES DEPT
SALEM, OREGON