


2 40 400

TOWNSHIP 1N RANGE 11E

SCALE: 4" = 1 MILE

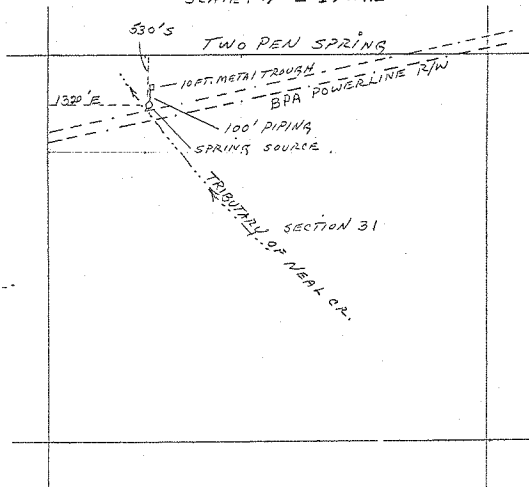

Application No. 61515

Permit No. 46460

RECEIVED
JUL 31 1981
WATER RESOURCES DEPT
SALEM, OREGON