
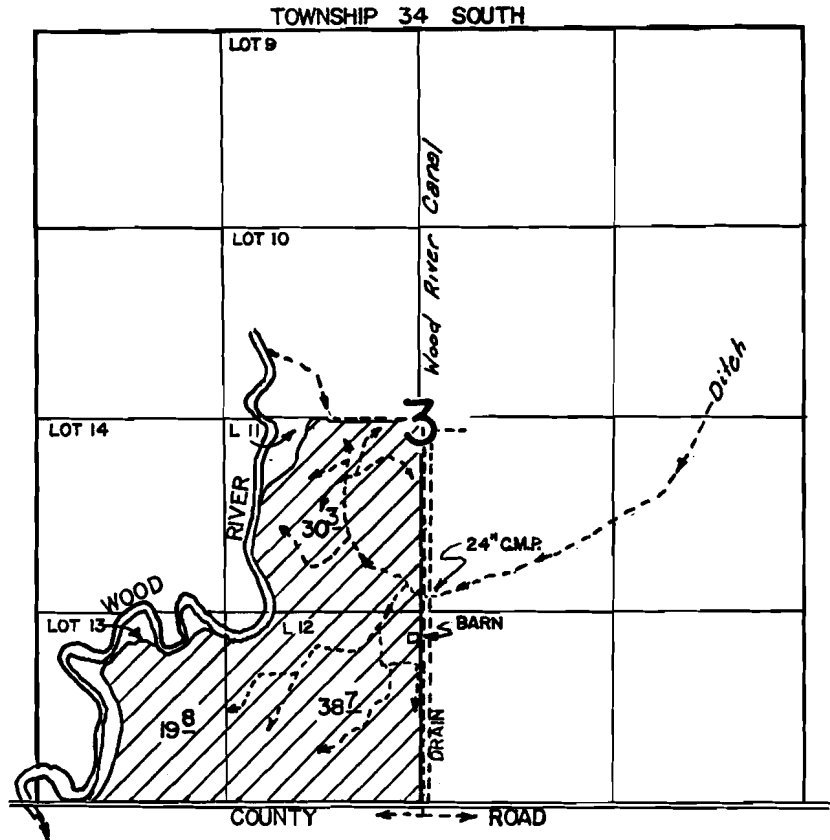


37501
54244

T. 33 & 34 S., R. 7½ E., W.M.

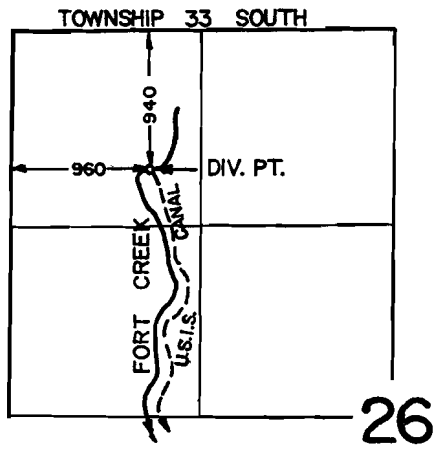

FINAL PROOF SURVEY UNDER

Application No. .51280... Permit No. ...37501.....
IN NAME OF

.....LLOYD...NICHOLSON.....

Surveyed ..JUNE..26 19..84, by ..M..BISH.....

Wood River Misc.
Vol. 1