


40324
54245

T.31S., R.16E., W.M.

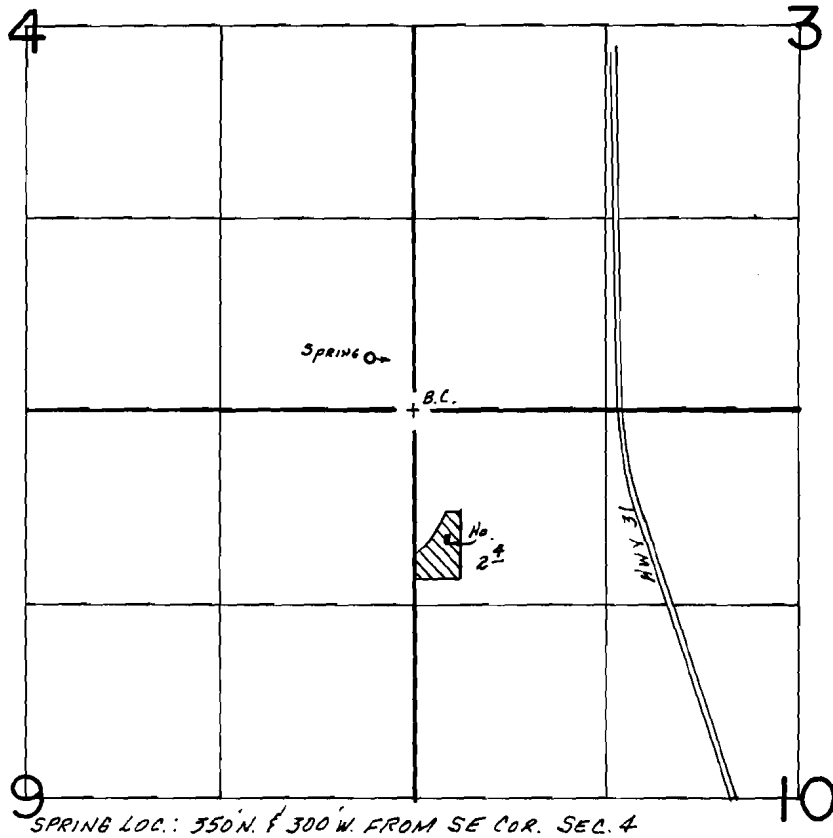

SCALE: 1" = 1320'

FINAL PROOF SURVEY
UNDER

Application No. 53605. Permit No. 40324.....
IN NAME OF

.....ARDYS MARKUS.....

Surveyed Oct. 15..... 1985., by ..B.W. BISHOP.....